


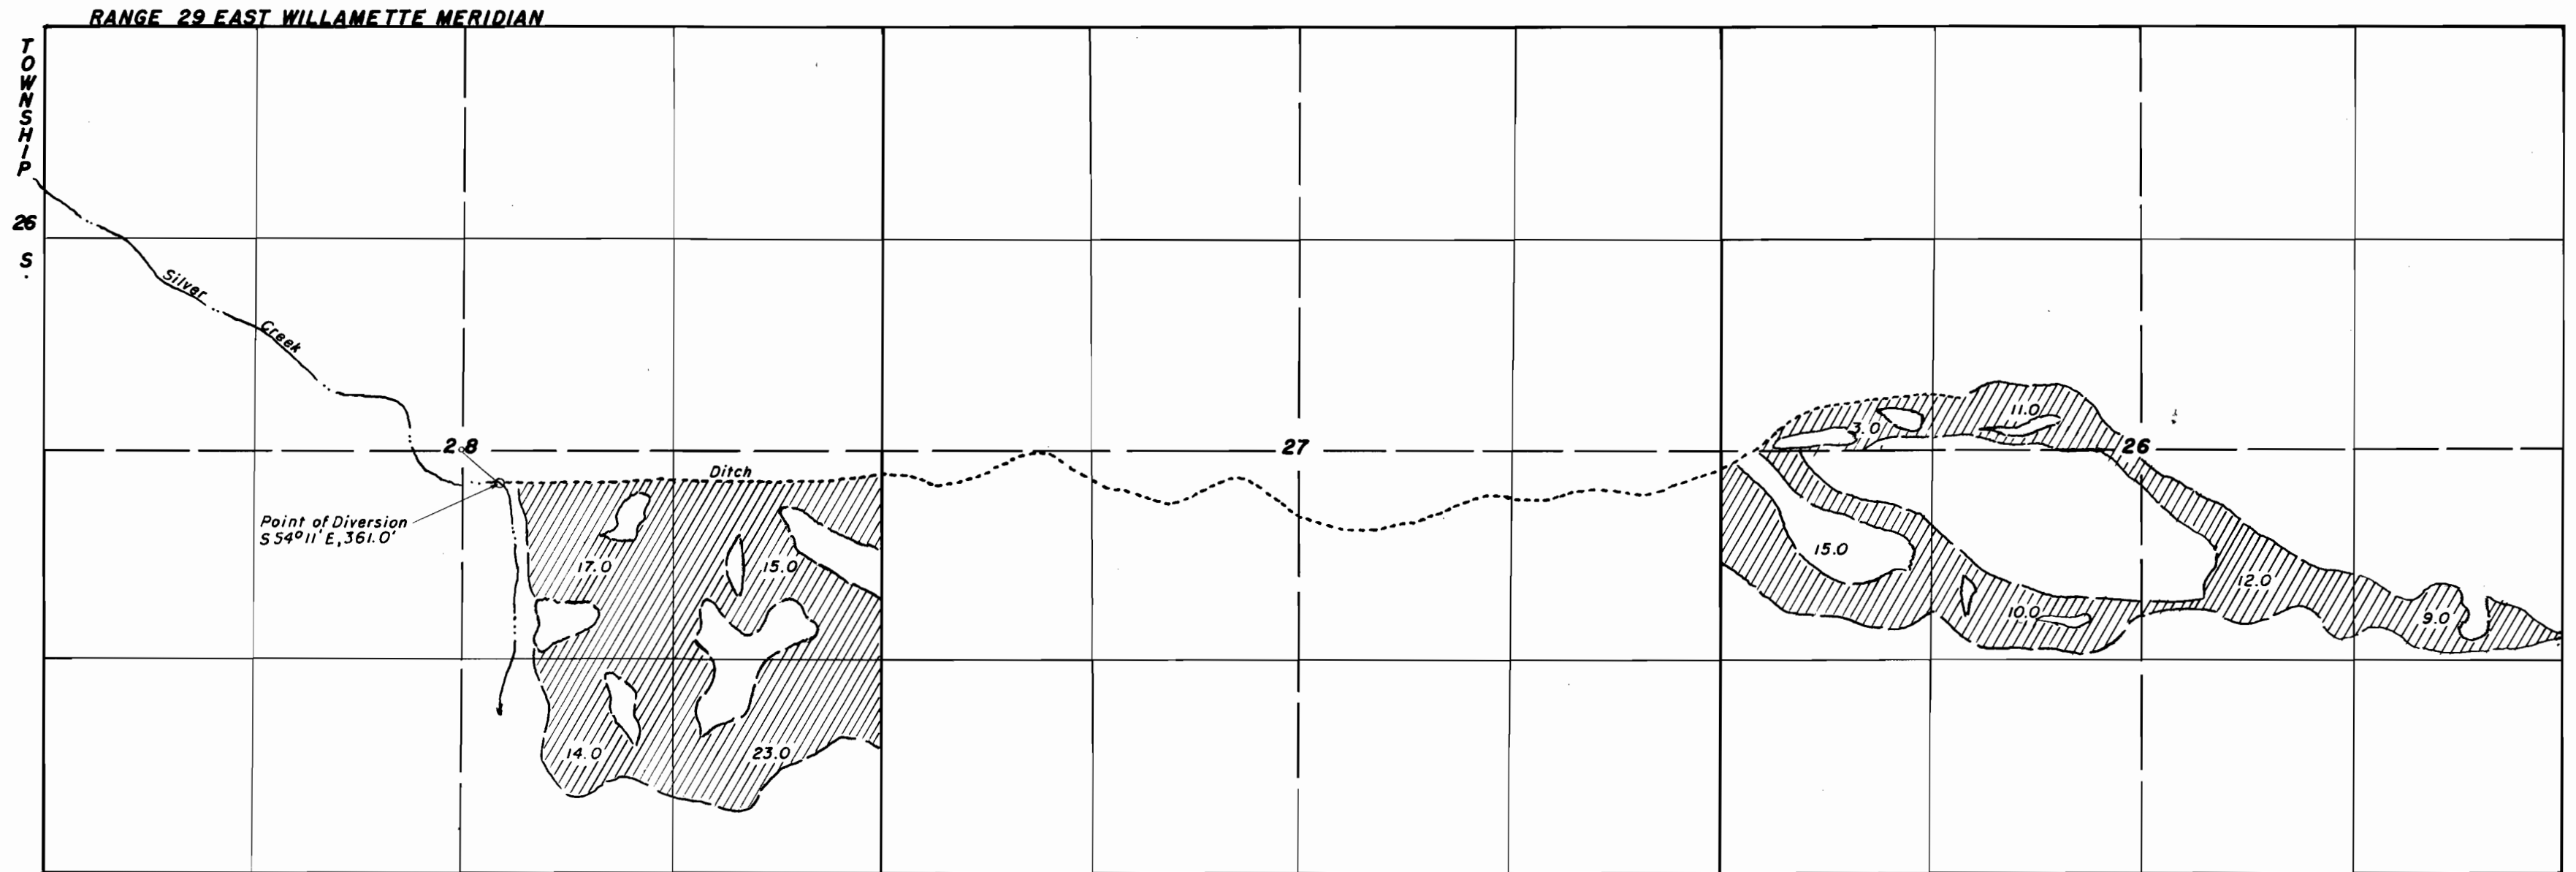

Scale: 6" = 1 Mile.

Louis M. Huguet
Application No. 27001
Permit No. 21207

Survey for Final Proof

27001