


T.3S.R.39E.WM

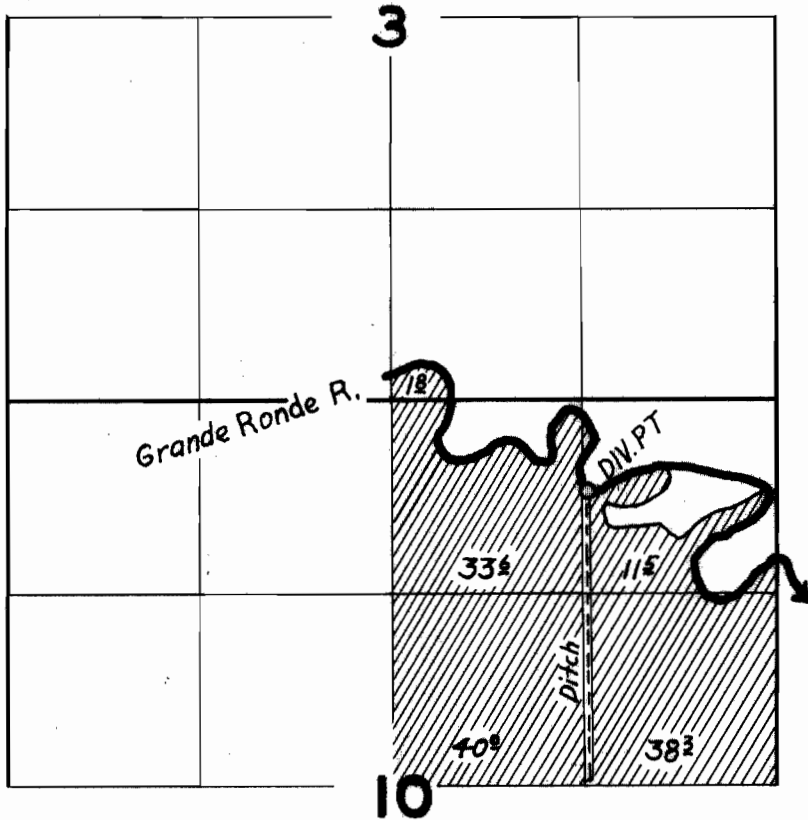

FINAL PROOF SURVEY UNDER

Application No. 208111 Permit No. 16305.....
IN NAME OF

..... Gilbert Courtright

Surveyed Oct. 7, 1953, by T. Jones