


T. 4 | S. R. 13 W. W. M.

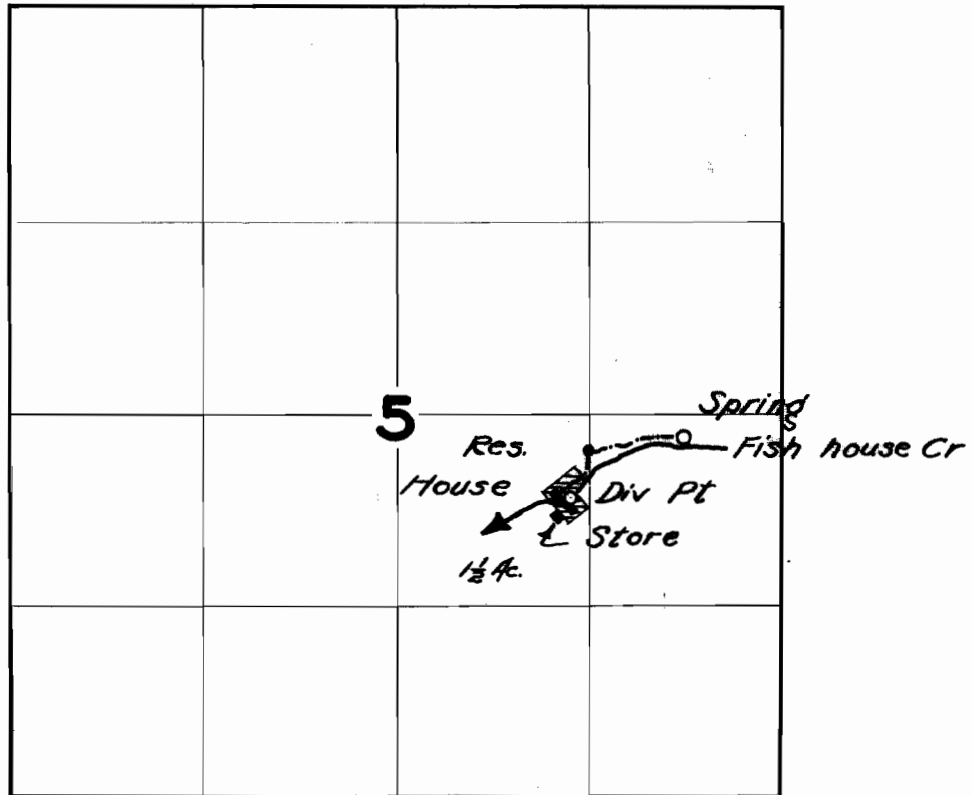

FINAL PROOF SURVEY
UNDER

Application No. 27577..... Permit No. 21718.....
IN NAME OF

E. E. Hanscam

Surveyed Sept 22 1953, by H. L. Coffman

1953-D