


T.3S.R.45E.WM

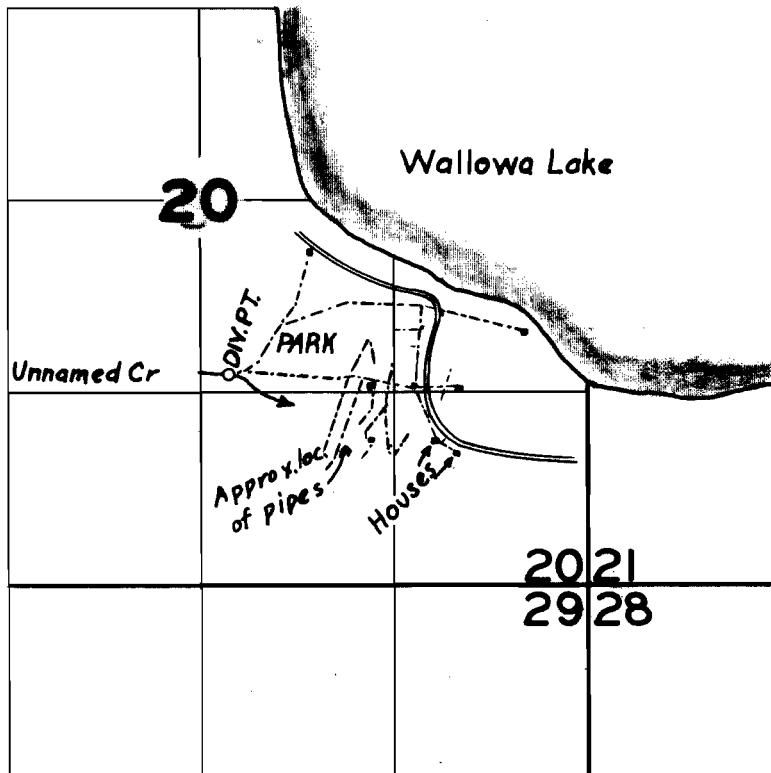

FINAL PROOF SURVEY UNDER

Application No. 27379..... Permit No. 21554.....

IN NAME OF

Oregon State Highway Commission

Surveyed Oct. 10 1953, by T. Jones