


T.41 S.R.13 W.W.M.

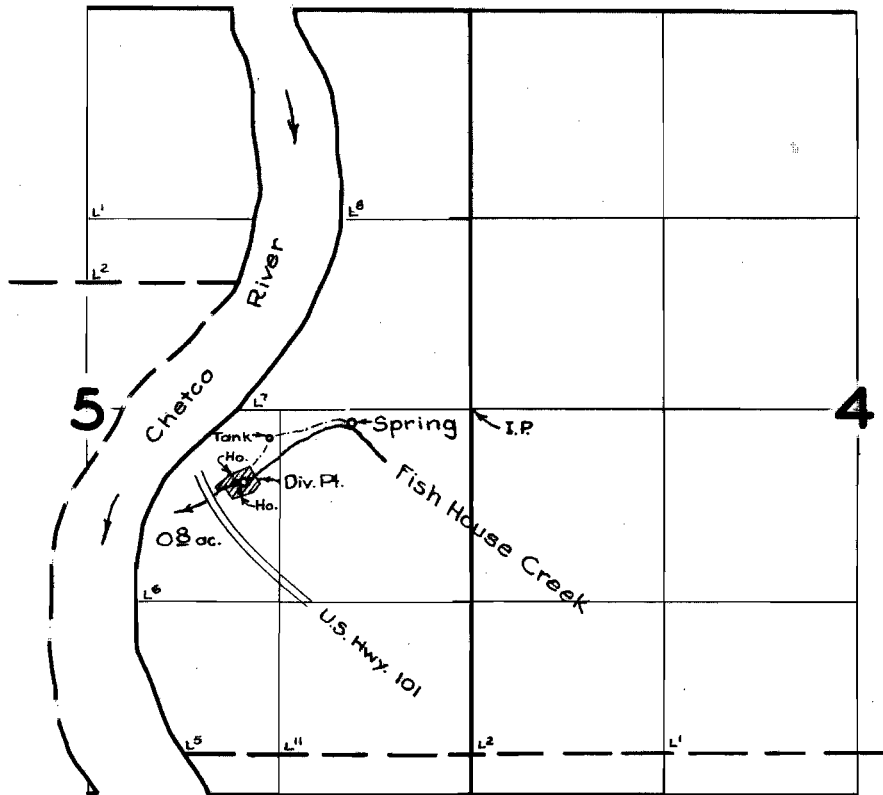

FINAL PROOF SURVEY UNDER

Application No. 27577 21718
27578 Permit No. 21719
IN NAME OF

E. E. Hanscam

Surveyed Mar. 18, 1958, by *m. Bish*