


# T.3S. R.4W.W.M.

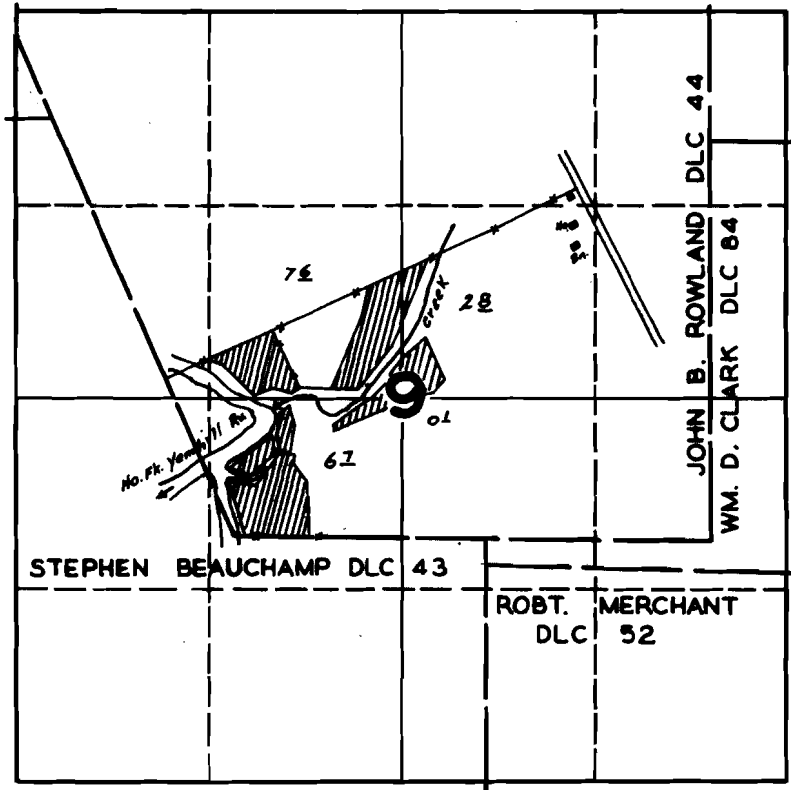

## FINAL PROOF SURVEY UNDER

Application No. 17728 Permit No. 13434

IN NAME OF  
WM. C. CHRISTENSON ET AL

Surveyed JUNE 30 1944, by

*James R. Sumrell*