


T.9S.R.3W.W.M.

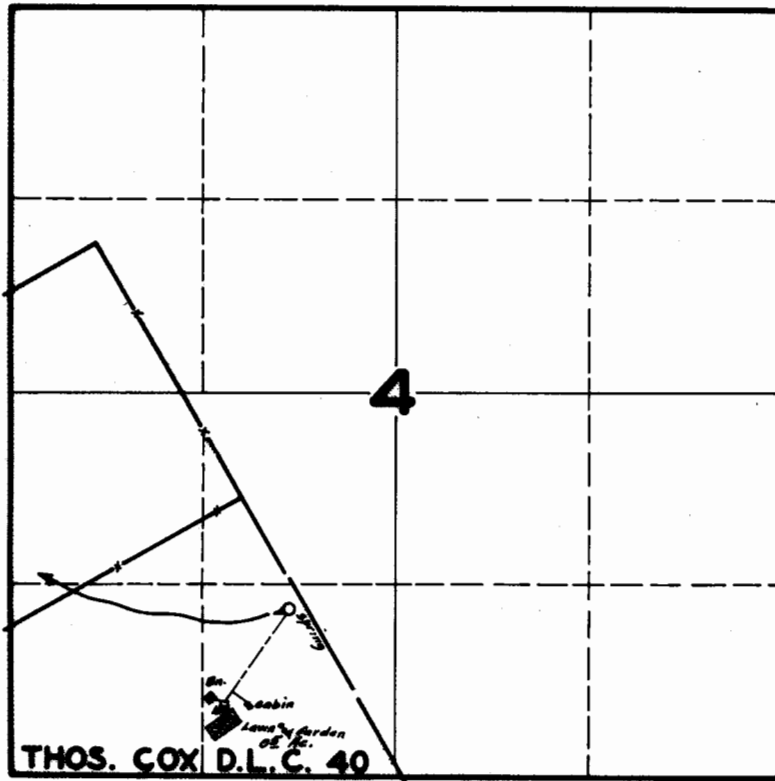

**FINAL PROOF SURVEY
UNDER**

Application No. 19985 Permit No. 15549

IN NAME OF

R. B. SEARS

Surveyed MAY 17, 1945, by Thos. Cox