


T.2S.R.3W.W.M.

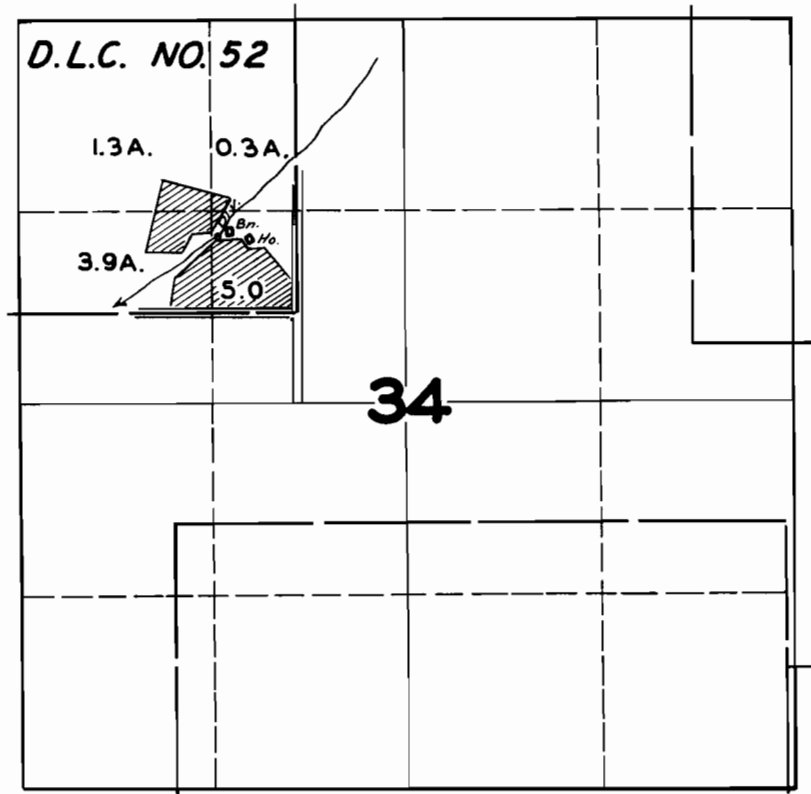

FINAL PROOF SURVEY UNDER

Application No. **21059** Permit No. **16502**
IN NAME OF

VICTOR THUMBERG

Surveyed **SEP. 22 1947**, by **JAS. E. BUNNELL**