


T. 31 S. R. 15 W. W. M.

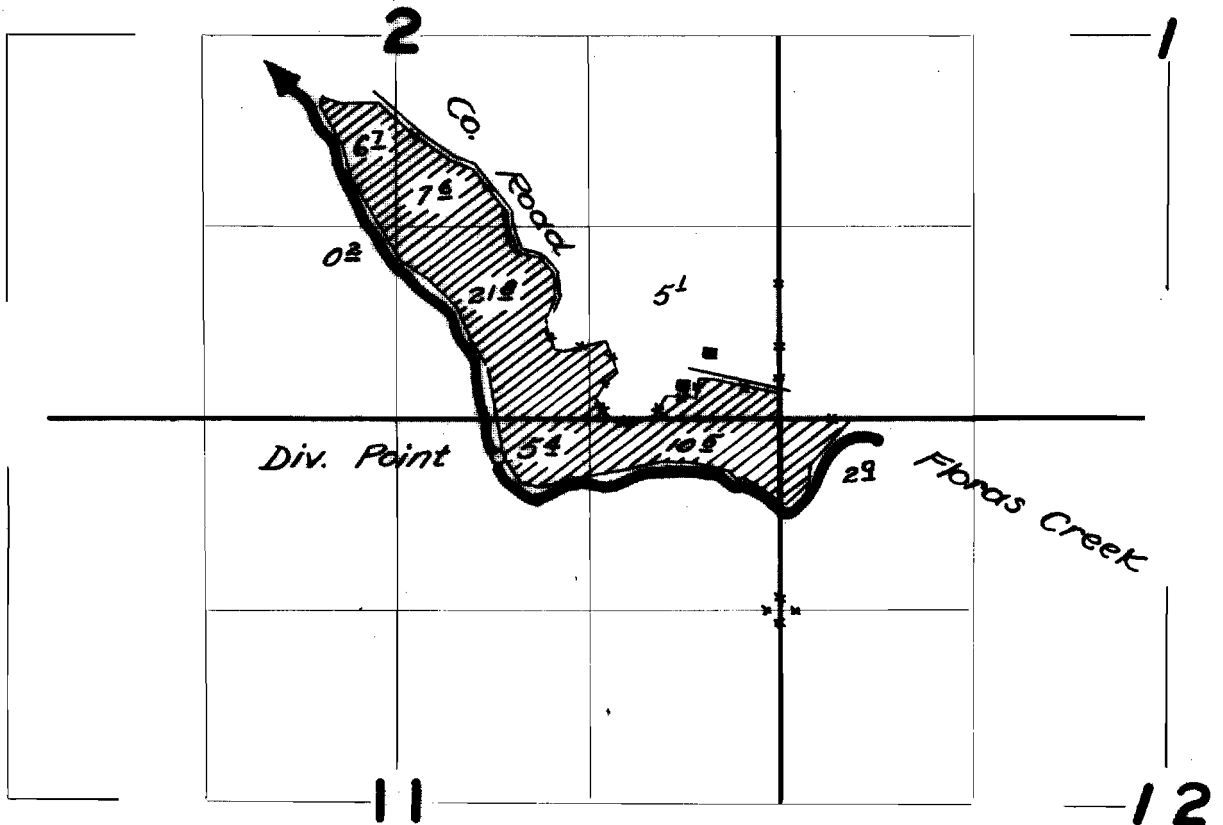

FINAL PROOF SURVEY
UNDER

Application No. 21853..... Permit No. 17228.....

IN NAME OF

L.E. Kreutzer & Sons

Surveyed Sept. 23, 1953, by H.L. Coffman