


T. 28 S. R. 6 W. WM

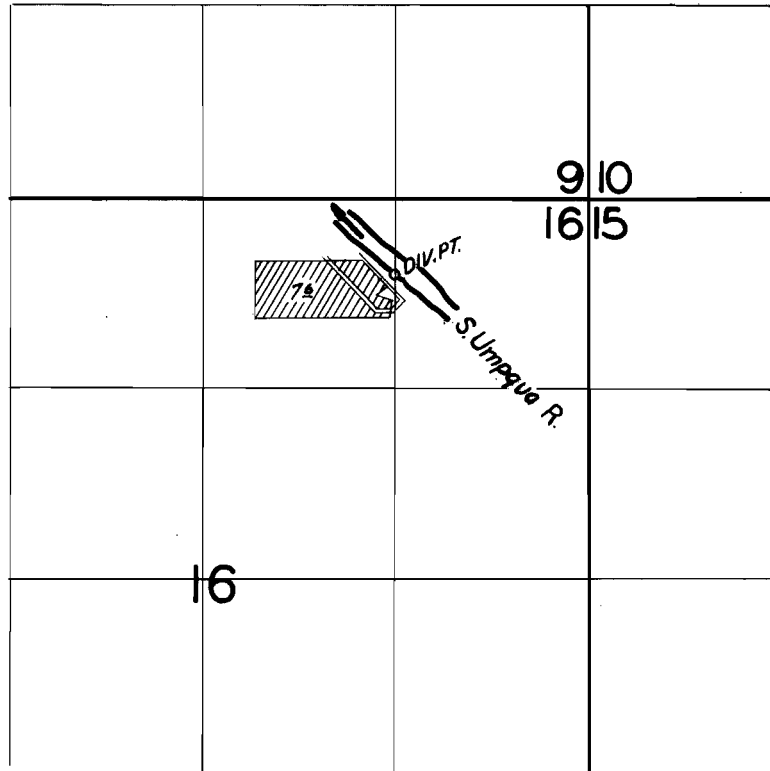

FINAL PROOF SURVEY

UNDER

Application No. 22360 Permit No. 17629

IN NAME OF

FRED G. ALBERTUS

Surveyed May 11 19 53, by T. JONES