


T. 4 S., R. 2 E., W.M.

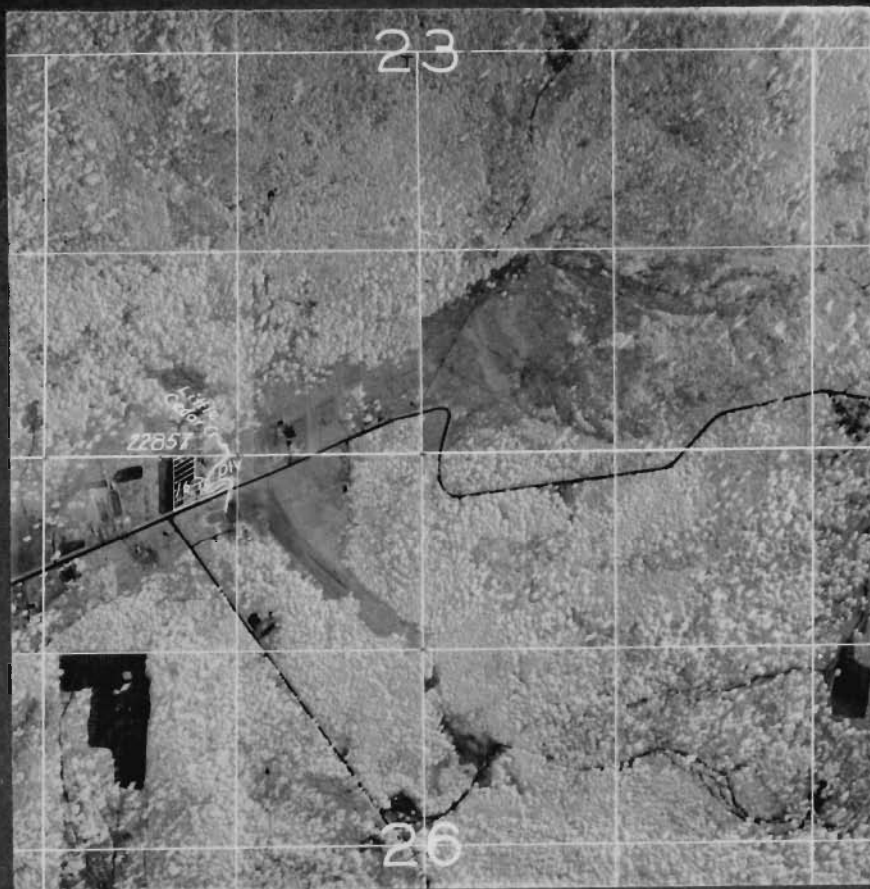

FINAL PROOF SURVEY

UNDER

Application No. 22857 Permit No. 18050
IN NAME OF

RICHARD R. TABOR

Surveyed May 29 1953 by H. L. Coffman

DFK-1D-32