


T. 13 S., R. 6 E., W.M.

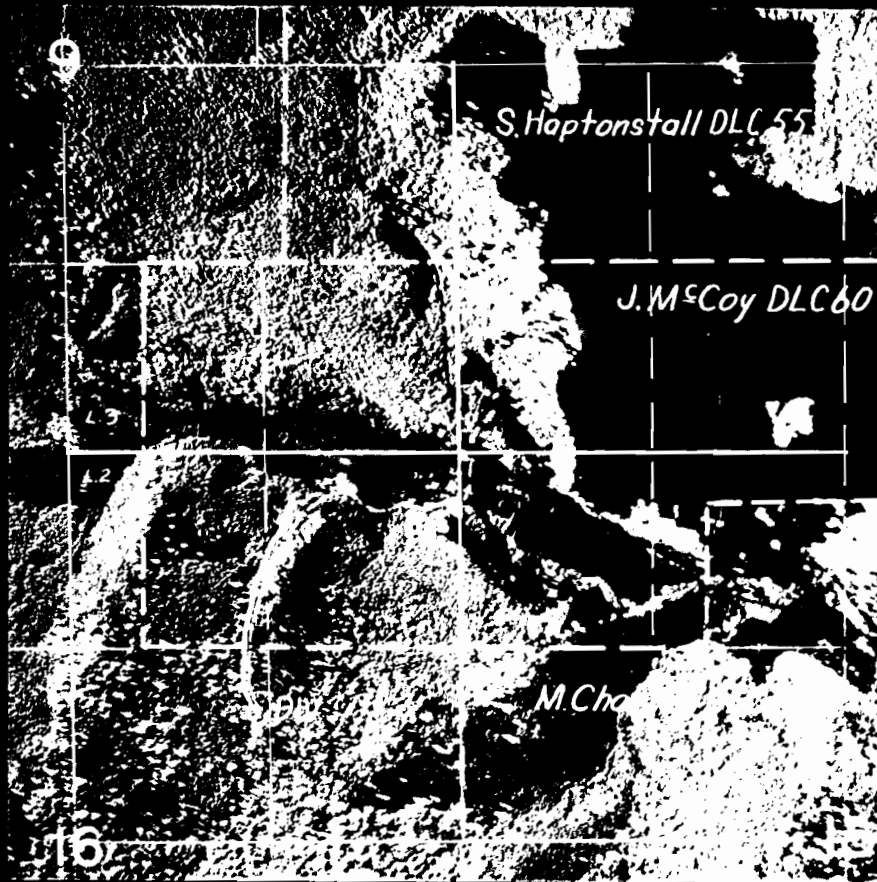

FINAL PROOF SURVEY

UNDER

Application No. 21911 Permit No. 17250.....

IN NAME OF

Ralph Hull

Surveyed Aug, 7, 1953., by R. L. Coffman.....

1001-31-119