


T.I.S.R.3 W.W.M

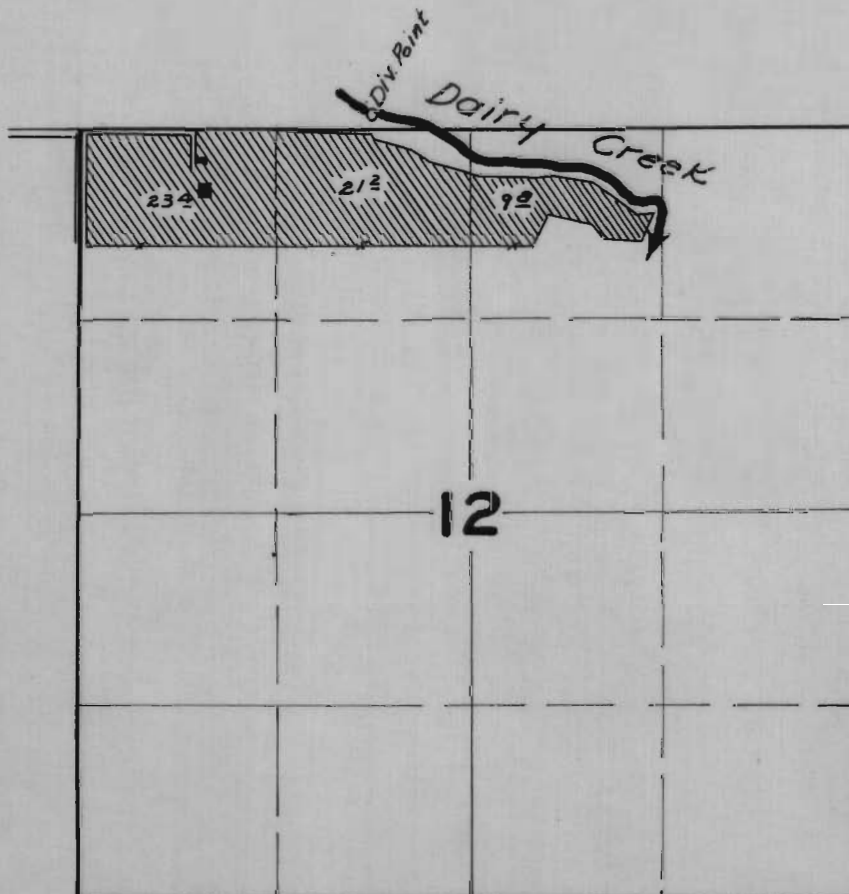

FINAL PROOF SURVEY

UNDER

Application No. 19414 Permit No. 14968

IN NAME OF

Emil H. & Anna H. Duyck

Surveyed May 15, 1952, by H. L. COFFMAN