


T.1&2 N.R.3 W. WM.

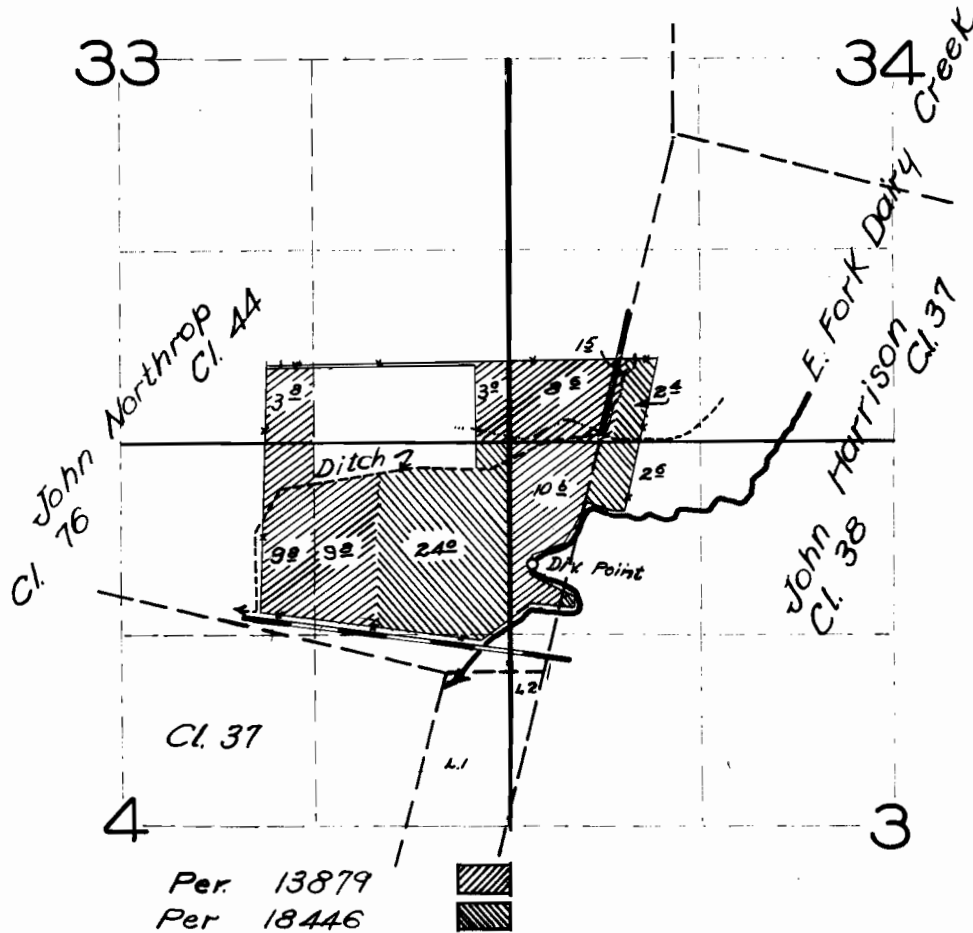

FINAL PROOF SURVEY

UNDER
23342 18446

Application No. 18171 Permit No. 13879

IN NAME OF

E. H. DUYCK

Surveyed 6 / 25 19.52, by H. L. COFFMAN