


T. 1 S. R. 2 W. W. M.

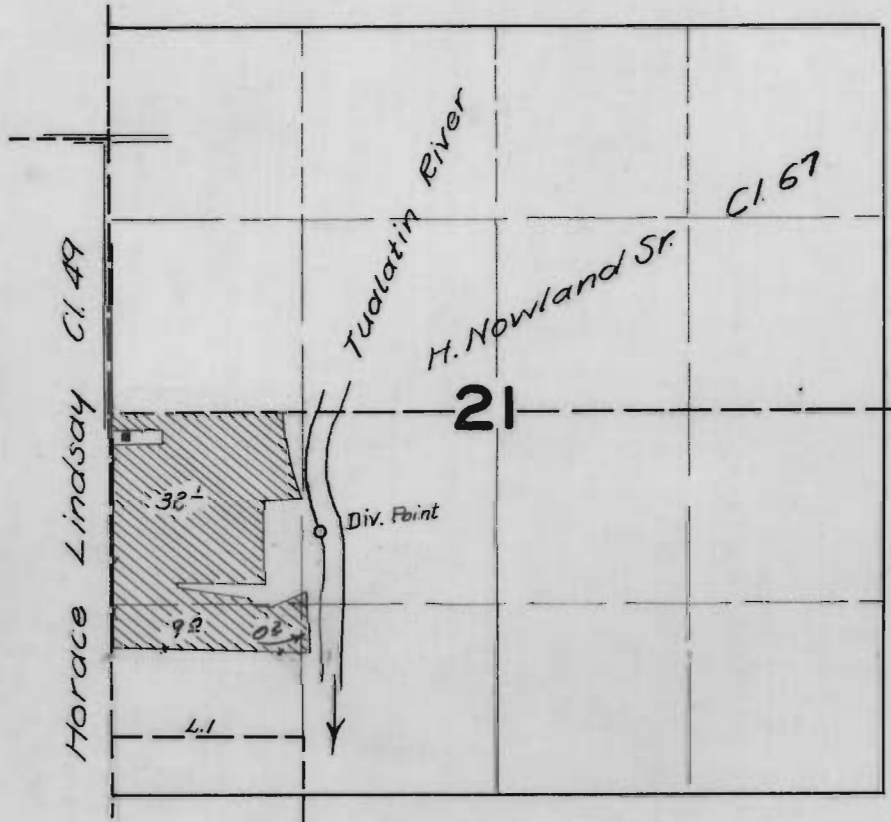

FINAL PROOF SURVEY

UNDER

Application No. 17750 Permit No. 13443

IN NAME OF

HAROLD H. and RHODA L. MEYERS

Surveyed 5 / 11 1952, by H. L. COFFMAN