


T.2S. R.5E.W.M.

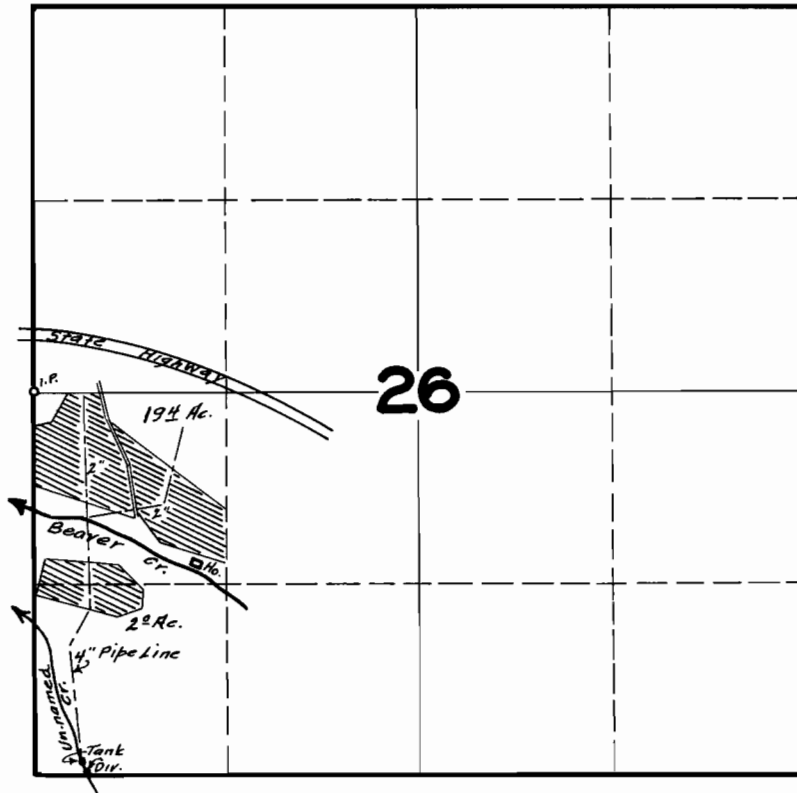

FINAL PROOF SURVEY
UNDER

Application No. 17883 Permit No. 13511

IN NAME OF

LUKE E. WALKER

Surveyed SEPT. 4 1947, by JAS. E. BUNNELL