


T.7S.R.1W.W.M.

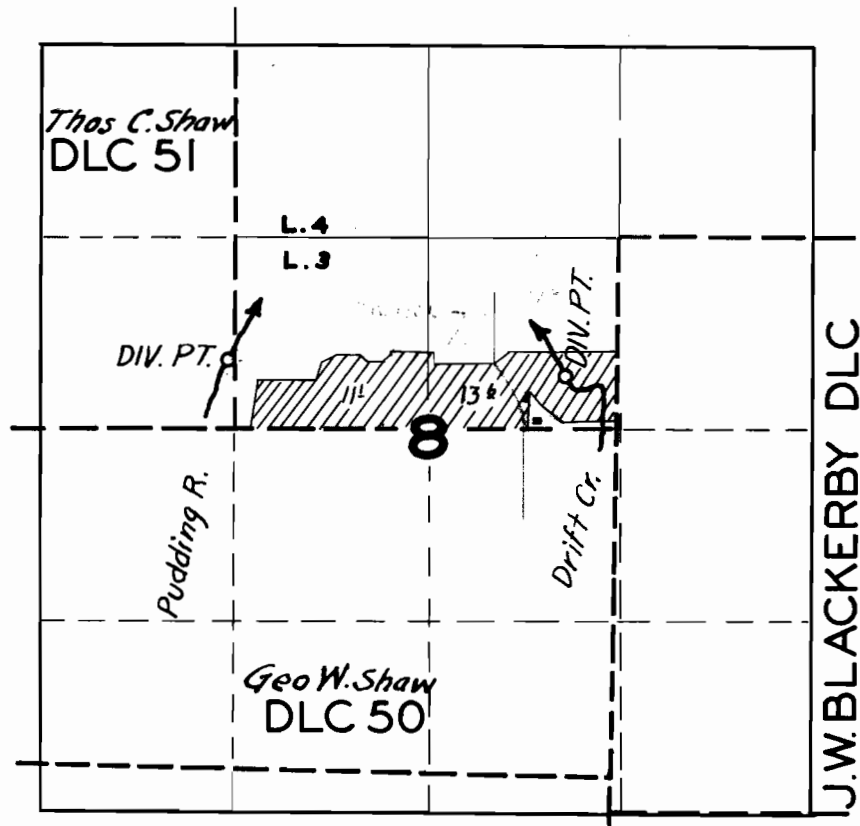

FINAL PROOF SURVEY

UNDER

Application No. 18977 Permit No. 14572

IN NAME OF

Werner Kellerhals

Surveyed Aug. 12 1952, by H. L. Coffman