T. 1N. R. 3E. W.M.

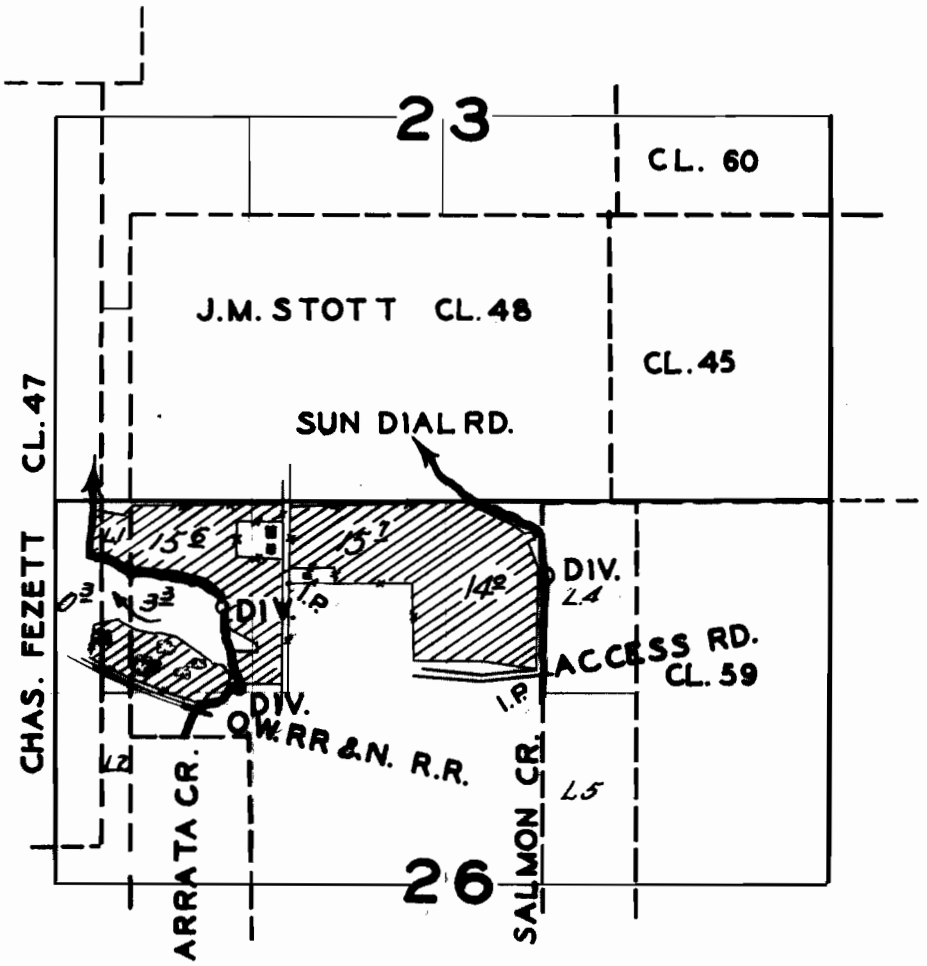

FINAL PROOF SURVEY

UNDER

Application No. 16014 Permit No. 11845

IN NAME OF

B. A. AND LOUISE B. KLIKS

Surveyed May 6 19 54 by H. L. Coffman

1954A