


T.2&3S. R. 4 4E. WM.

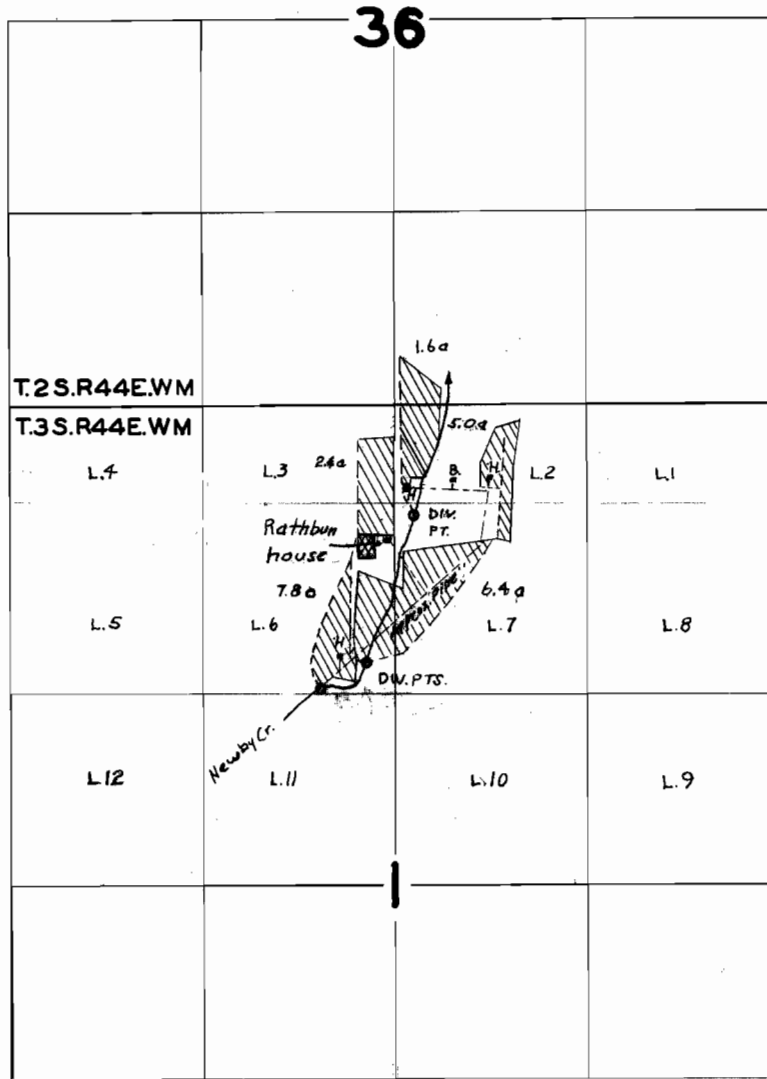

FINAL PROOF SURVEY UNDER

JAY & WAYNE BOWERMAN APPL. NO. 18586, PERMIT NO. 14581

RICHARD E. RATHBUN APPL. NO. 27962, PERMIT NO. 12002

Surveyed Oct. 13 1953, by T. Jones