


T.I.S.R.I.W.W.M.

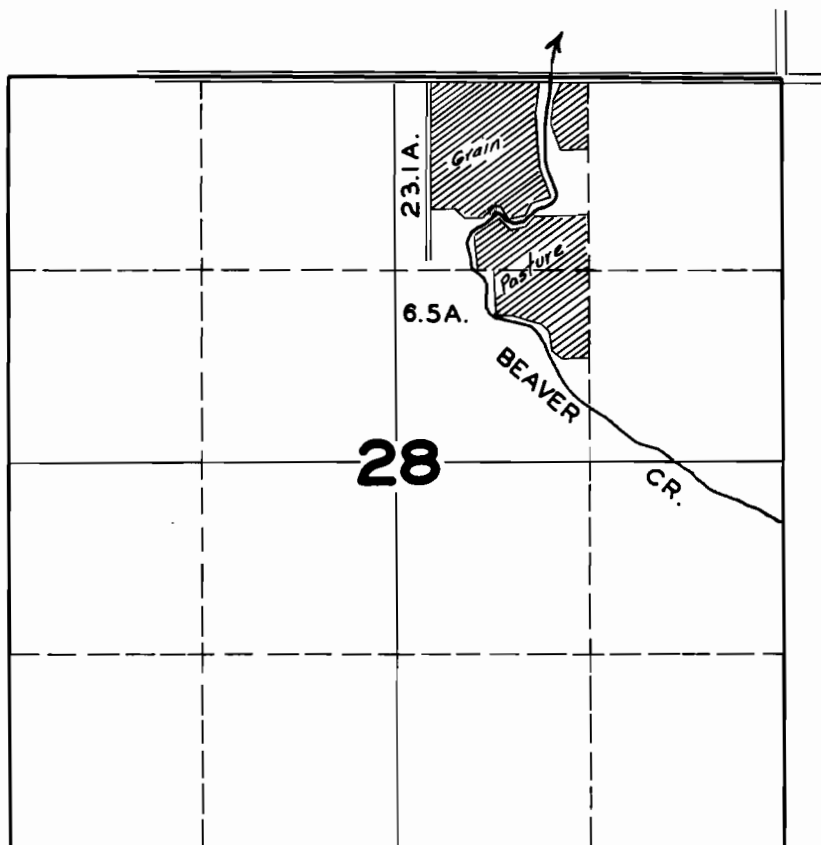

FINAL PROOF SURVEY

UNDER

Application No. 20348 Permit No. 15872

IN NAME OF

G. E. DYKSTRA

Surveyed MAY 9 1947, by JAS. E. BUNNELL