
T. IS. R.IW.W.M.

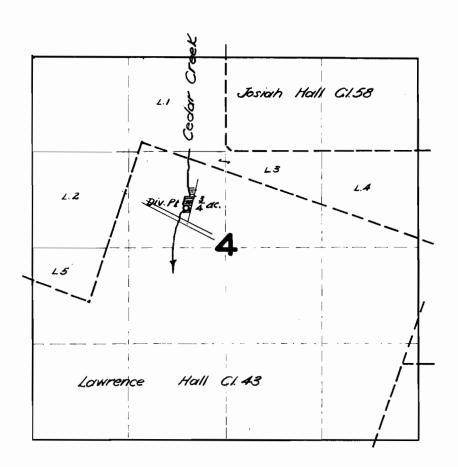

FINAL PROOF SURVEY

UNDER

Application No. 23346 Permit No. 18447

ALAN F. NELSON

Surveyed June 5, 19 52, by H. L. COFFMAN