


T. 12 S. R. 6 W. W. M.

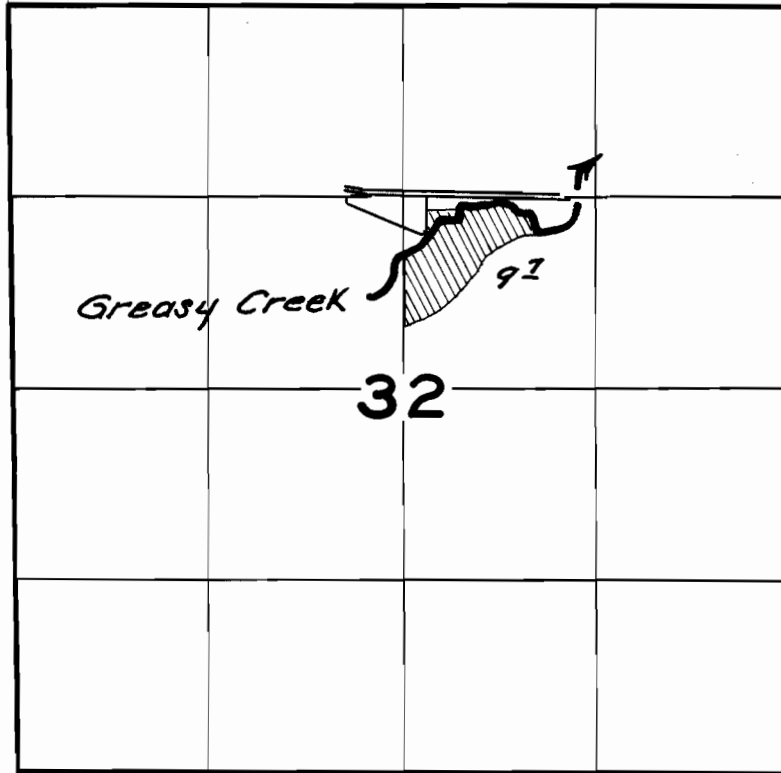

**FINAL PROOF SURVEY**

UNDER

Application No. 20518..... Permit No. 19308.....

IN NAME OF

Earl Hawkins

Surveyed Aug. 5, 1923, by H. L. Coffman