


T 1 S. R. 2 W. W. M.

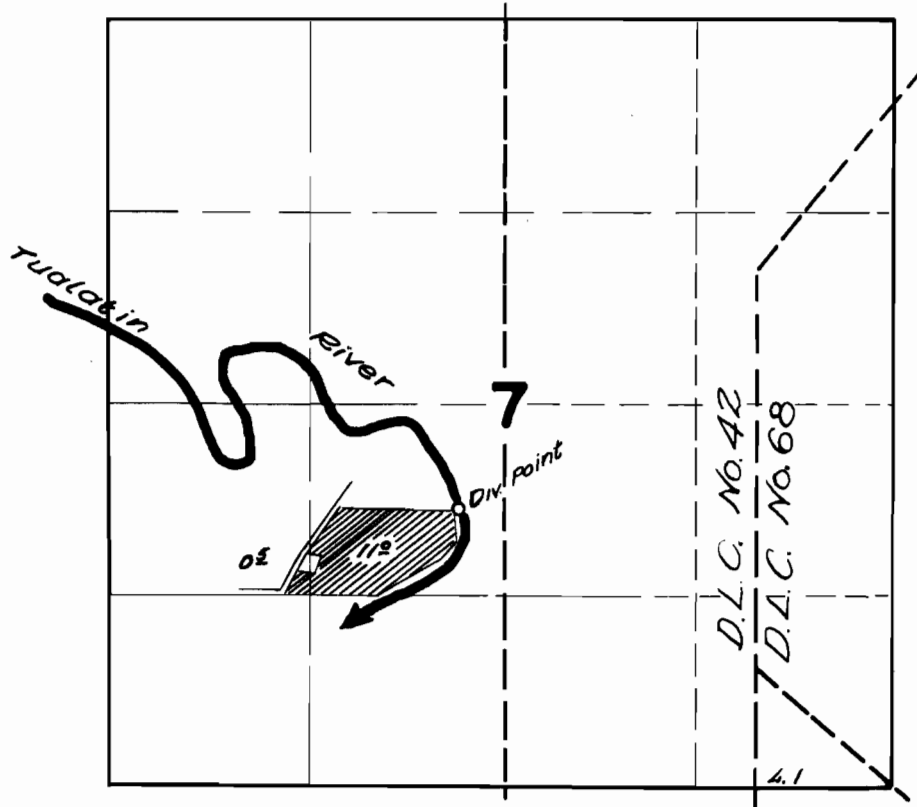

FINAL PROOF SURVEY

UNDER

Application No. 24661 Permit No. 19404

IN NAME OF

DONALD J. MORILON

Surveyed 4 / 28 1952, by H. L. COFFMAN