


T.32S.R.15W.WM

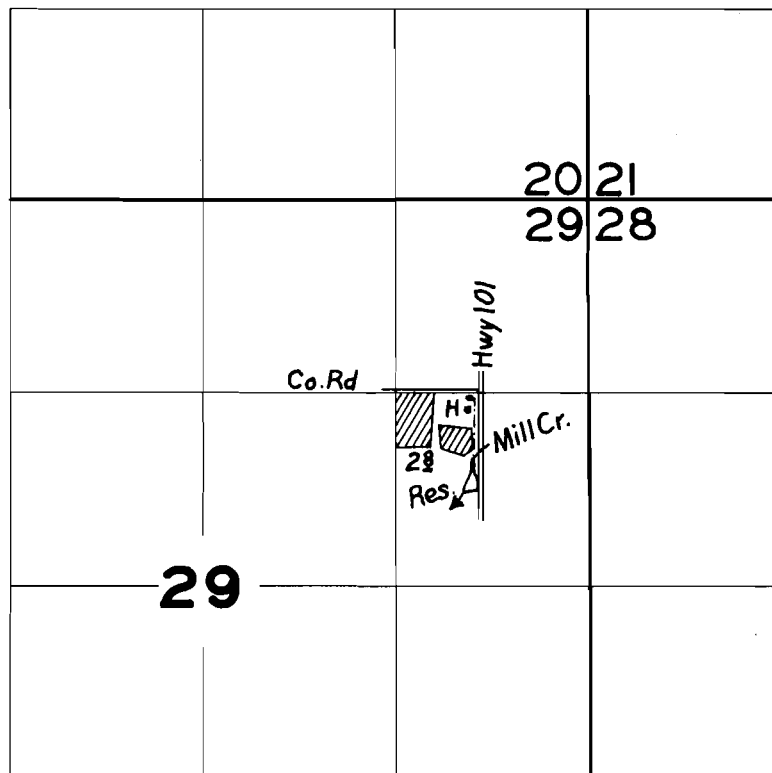

FINAL PROOF SURVEY

UNDER

R-22426

R-880

Application No. 22427..... Permit No. 17707.....

IN NAME OF

Larry Rickman

Surveyed Sept 24 1953, by T. Jones

1953-Y