


# T.15S. R.44&45E.WM

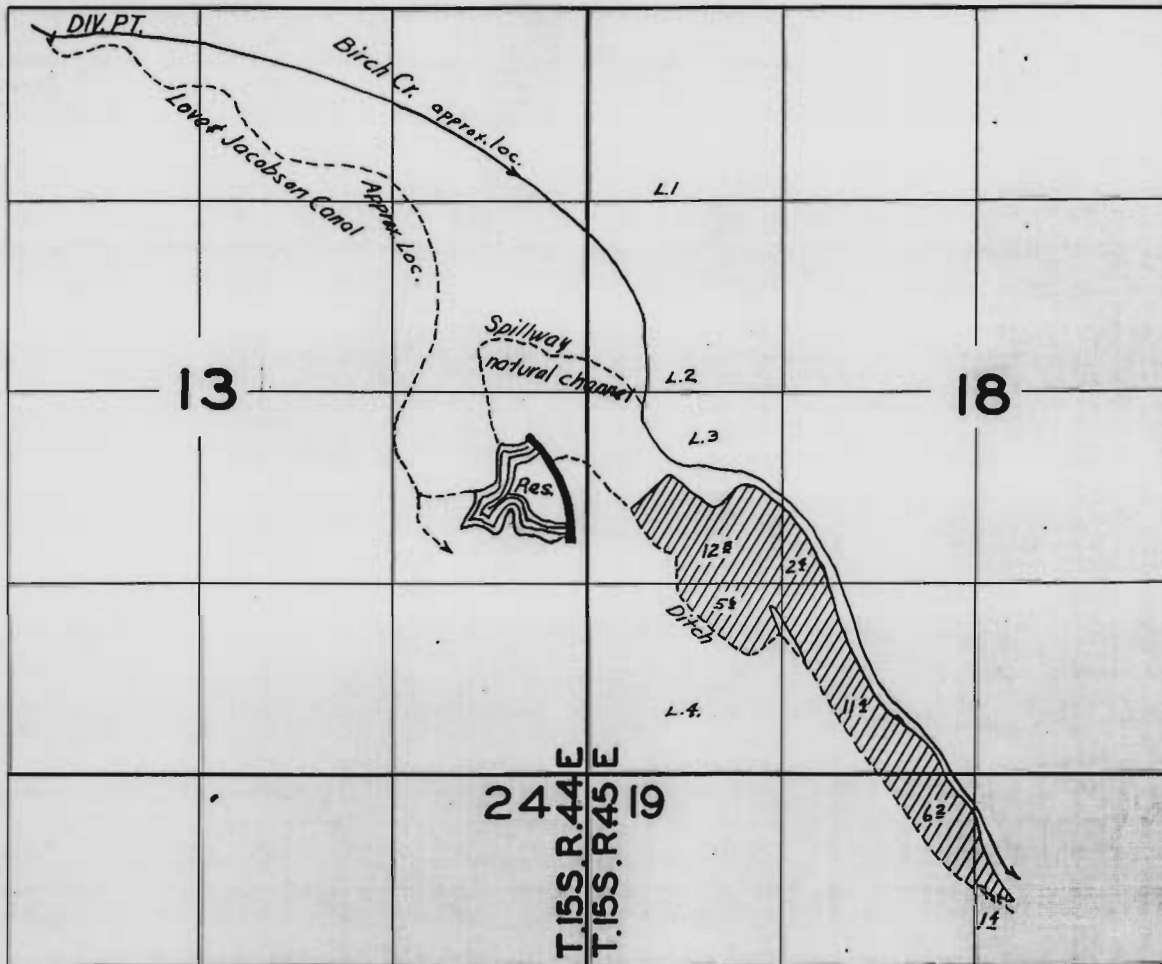

## FINAL PROOF SURVEY

UNDER

R-24019

R-990

Application No. 24084

Permit No. 18967

IN NAME OF

DWIGHT LOCKETT

Surveyed July 7 1953, by T. Jones

COPY from R 24019

1953Z