


T. 38 S., R. 7 W., W. M

Scale 4" = 1 Mile

Jan. 1952

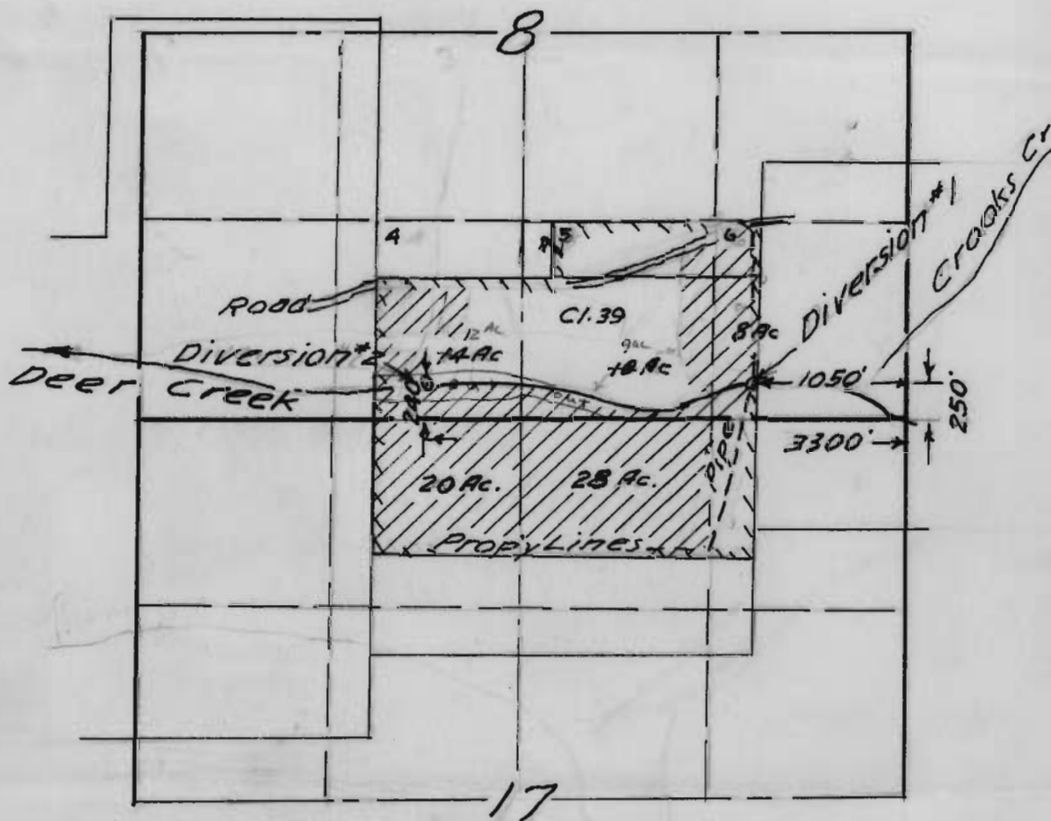

Oliver Smith

RECEIVED

JAN 8 1952

Application No. 26769 STATE ENGINEER
Permit No. 20935 SALEM, OREGON