


T. 37 S. R. 7 W., W. M.  
Scale 4" = 1 Mile Jan. 1953  
Edgar R. Coutts.

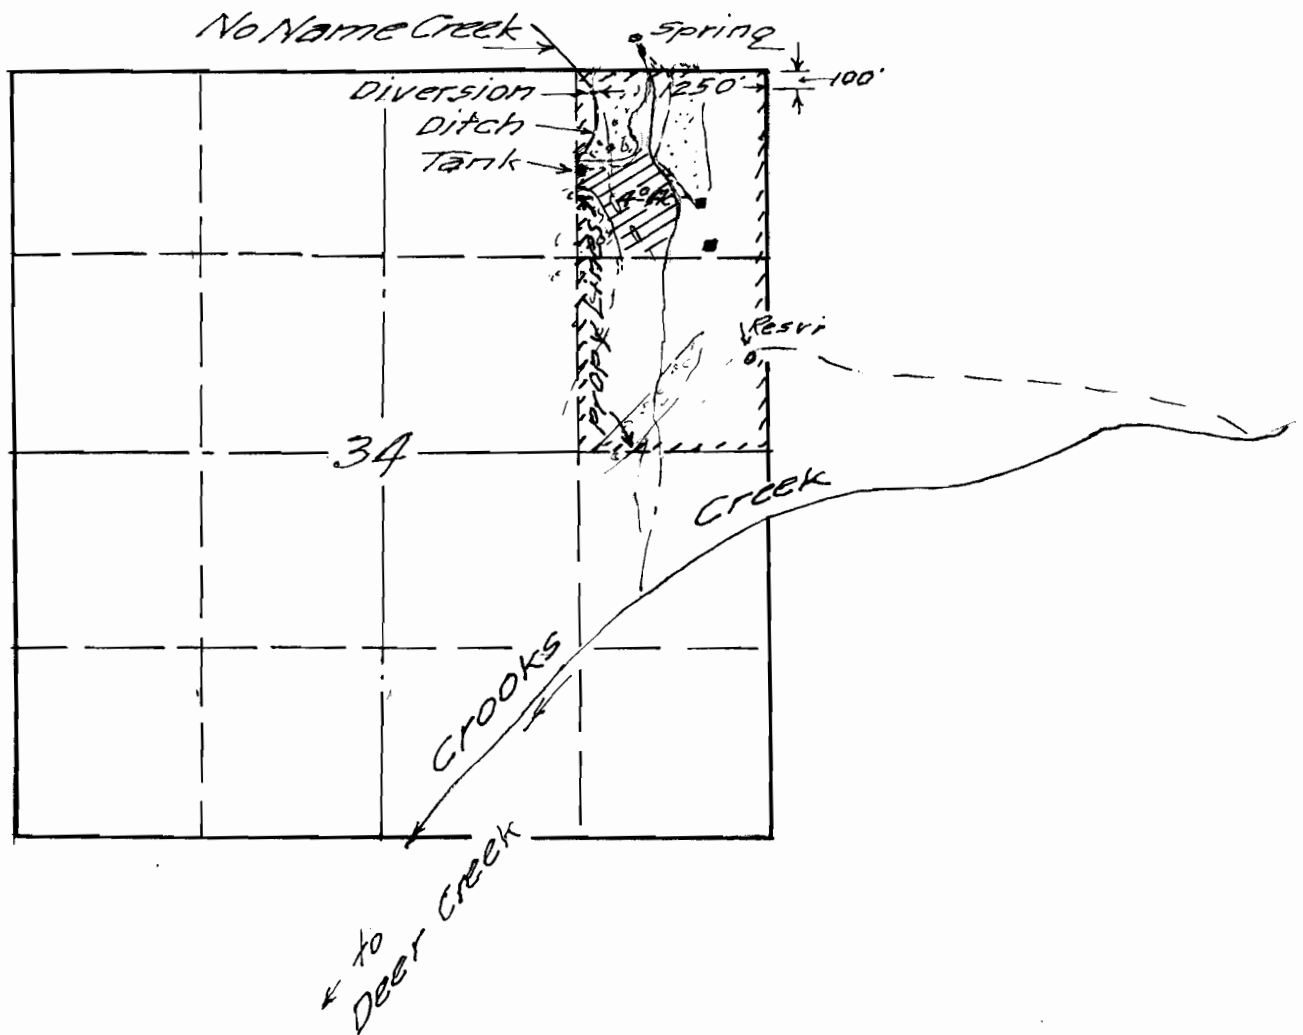

Application No. 27995  
Permit No. 22034