# T3S.R.45E.W.M.

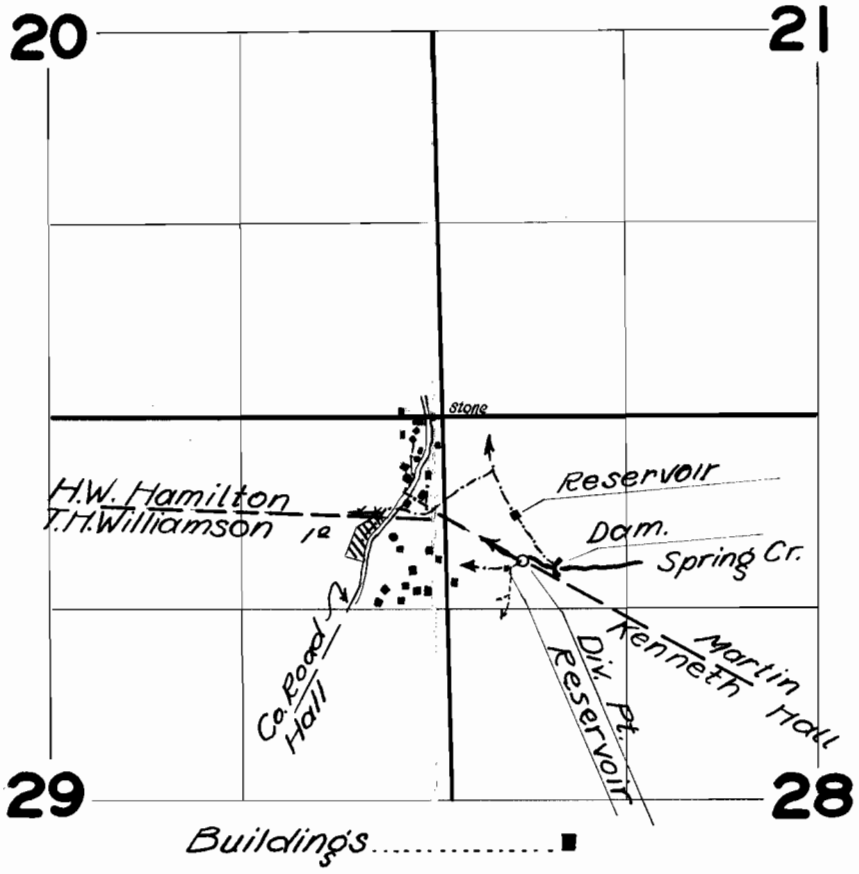


FINAL PROOF SURVEY

UNDER

Application No. 3198, 3199, 3200 Permit No. 18423, 18424, 18425

IN NAME OF

Kenneth Hall

T. H. Williamson Harley Hamilton

Surveyed Oct. 14 1953, by H. Hoffman

1953-