


T3S.R.45E.W.M.

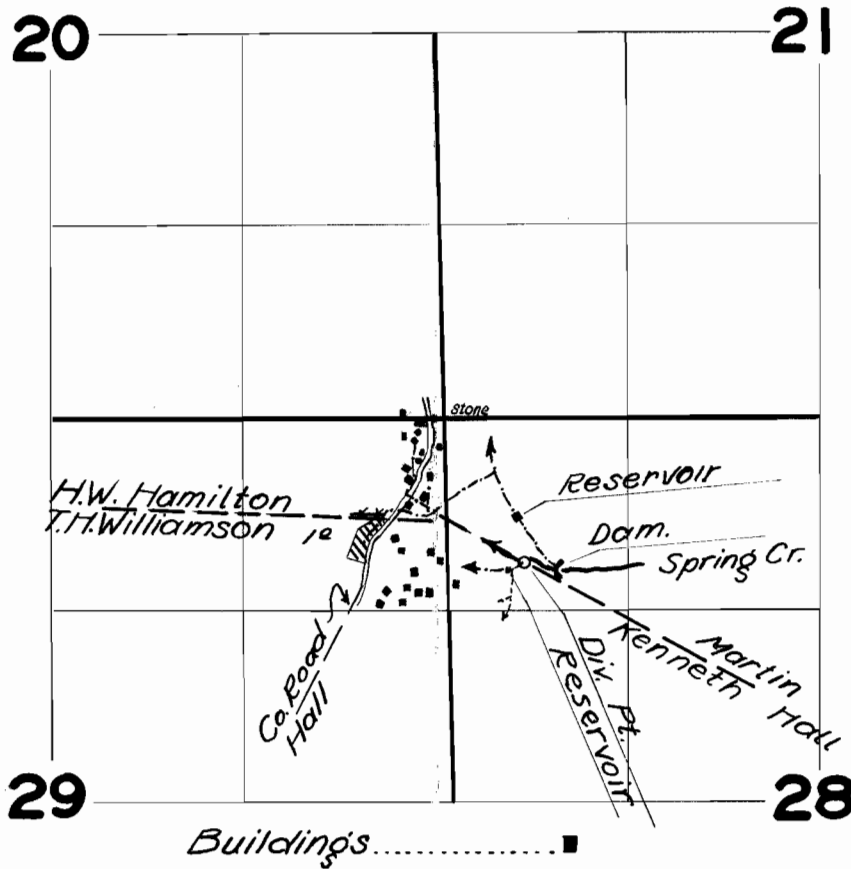

FINAL PROOF SURVEY

UNDER

Application No. 18196 18123
 18199 18124
 3200 Permit No. 18125

IN NAME OF

Kenneth Hall

P. B. Williamson and Harlow M. Hamilton

Surveyed Oct 14, 1953, by H. J. Hoffman