


T.6N.R.35E.W.M.

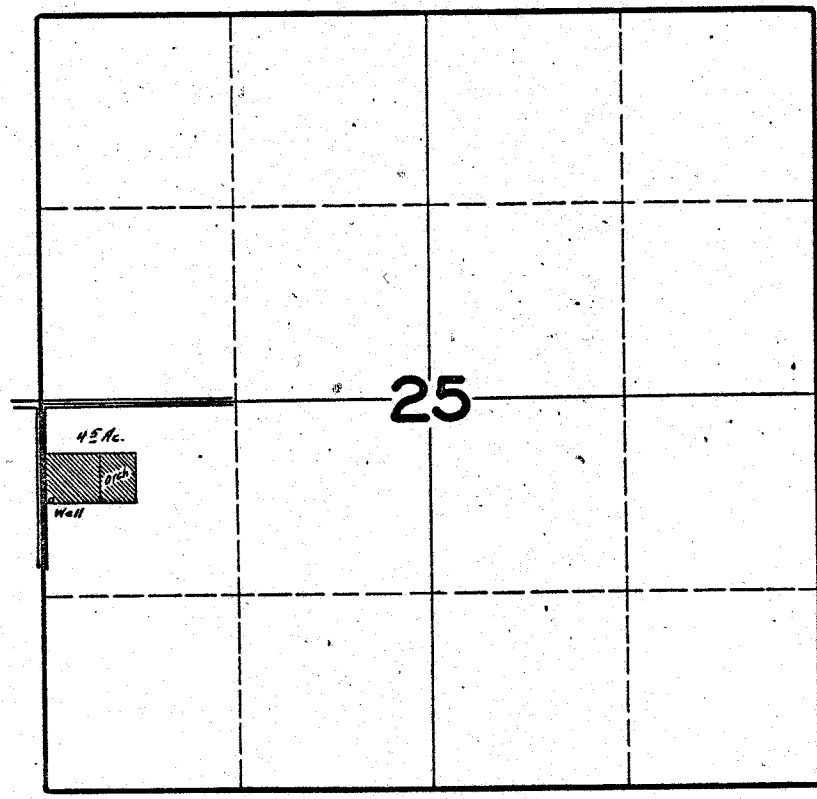

FINAL PROOF SURVEY UNDER

Application No. U-133 Permit No. U-125

IN NAME OF

R. P. STRIMPLE

Surveyed APR. 17 1946, by [Signature]