


# T. 2S. R. 2W. W.M.

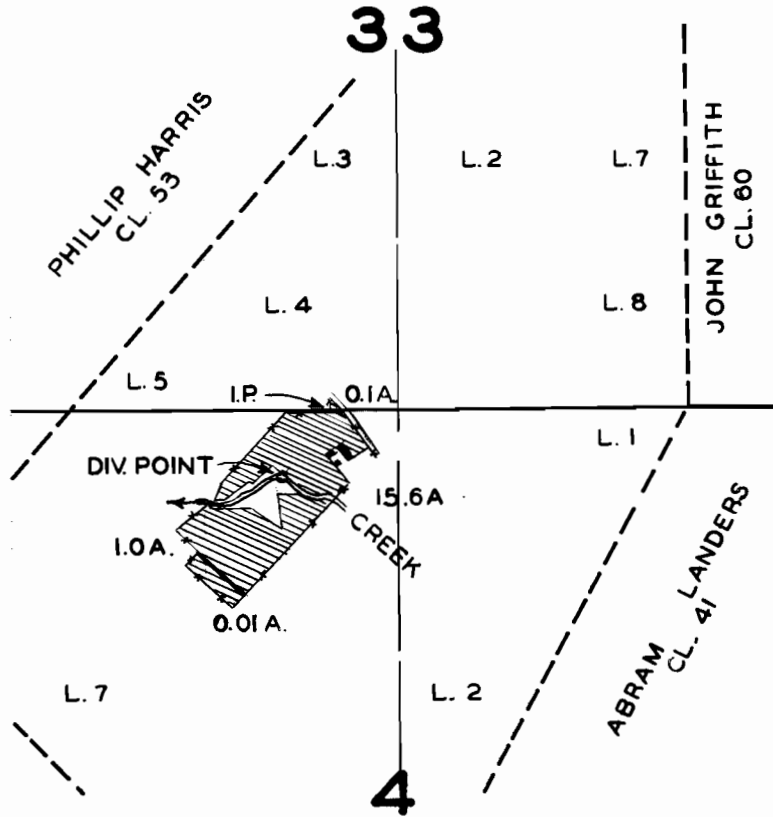

## FINAL PROOF SURVEY

UNDER

Application No. **18174** ... Permit No. **13808**  
IN NAME OF

**VICTOR D. FOSTER**

Surveyed NOV 7, 1949, by H.L. COFFMAN.