


T.17S.R.5W.W.M.

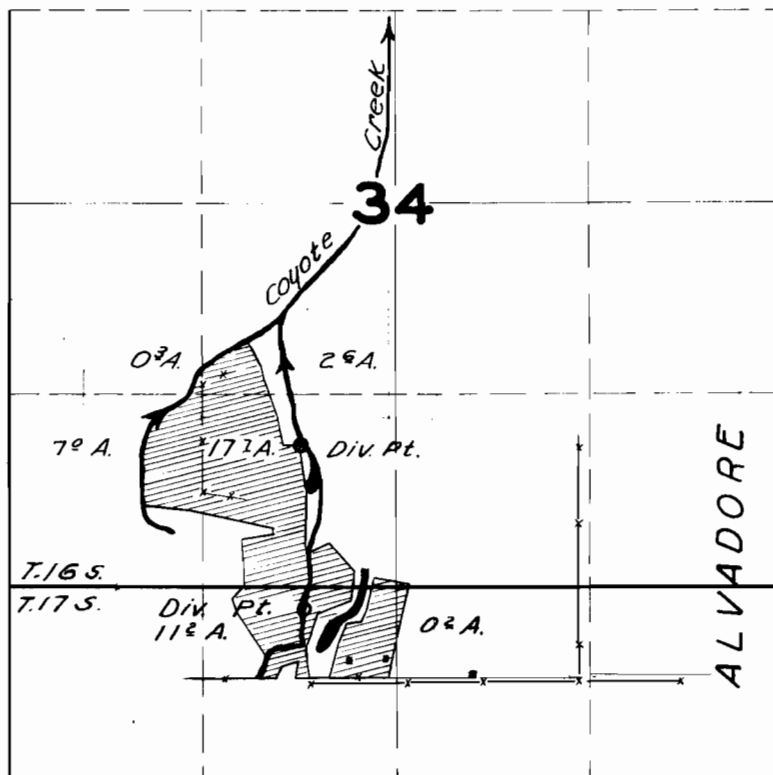

FINAL PROOF SURVEY

UNDER

Application No. **19477** Permit No. **15095**

IN NAME OF

R.A. BABB & B.A. BABB

Surveyed **MAY 25, 1949**, by **H.L. COFFMAN**