


T. 3 N. R. 3 W. W M

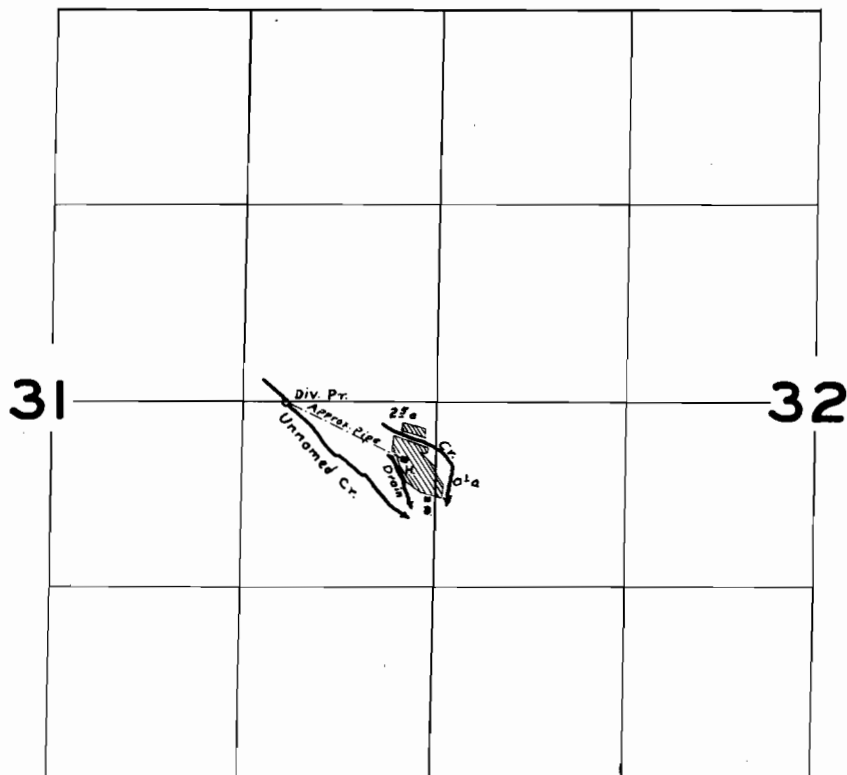

FINAL PROOF SURVEY

UNDER

Application No. 21120 Permit No. 16550

IN NAME OF

CHAS. O'HAYER, A. H. & EDITH M. NEWTON

Surveyed April 21 1953, by H. L. Coffman