


T.5S.R.1W.W.M.

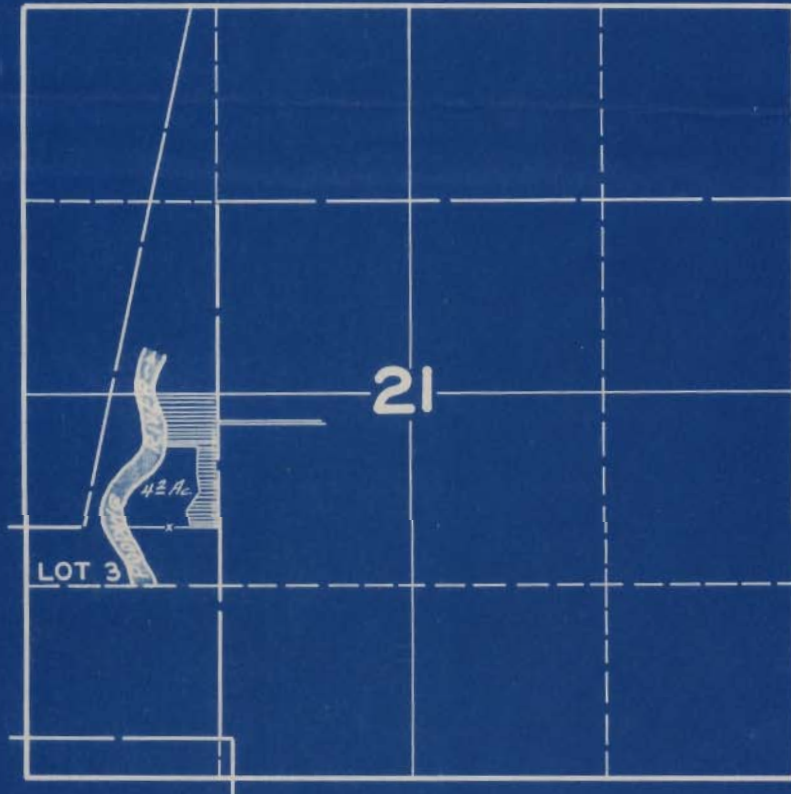

FINAL PROOF SURVEY
UNDER

Application No. 20715 Permit No. 16312

IN NAME OF

CORDES SEETHOFF

Surveyed OCT. 28 1947, by JAS. E. BUNNELL