


**T.9S.R.3W.W.M.**

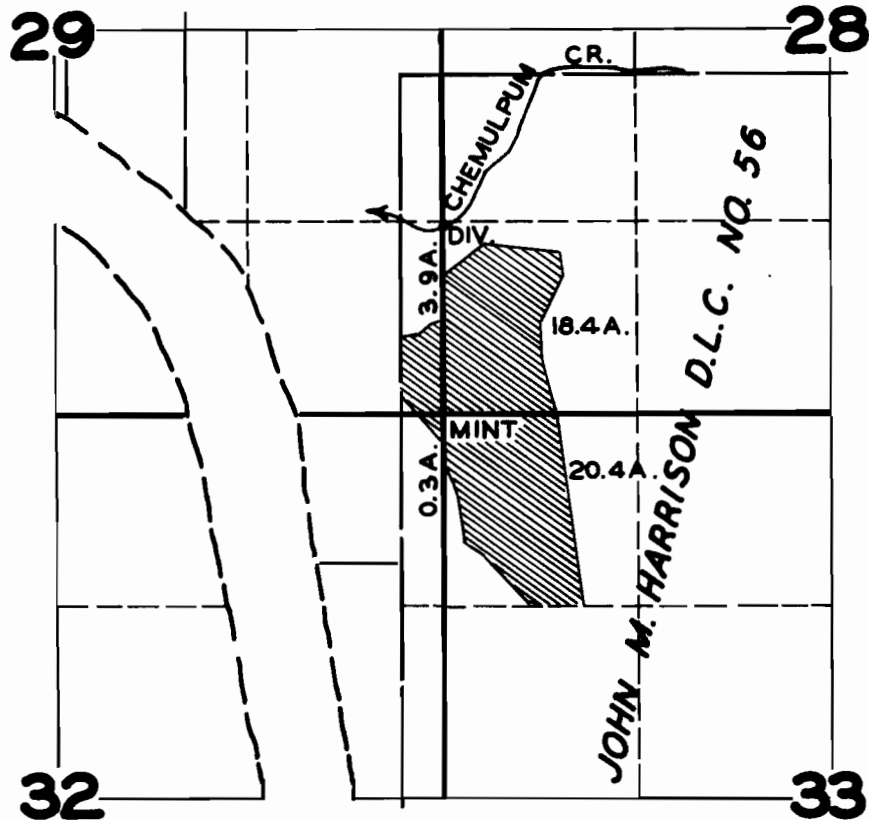

**FINAL PROOF SURVEY**

UNDER

Application No. **22166** Permit No. **17454**

IN NAME OF

**KAREL TOMASEK**

Surveyed **MAY 27, 1947**, by **JAS. E. BUNNELL**