


T. 2 S., R. 4 E., W.M.

R-19069 ²⁴ 19070

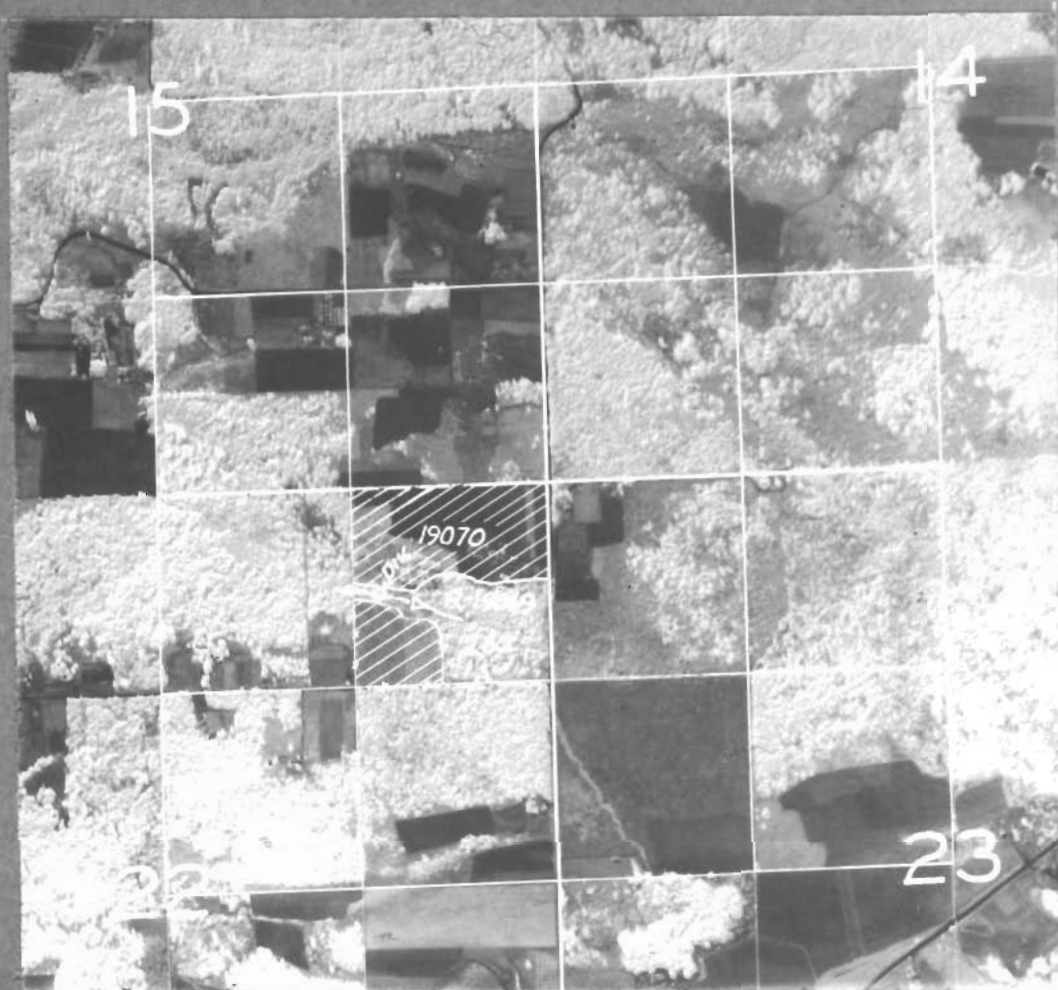

FINAL PROOF SURVEY

UNDER

R-19069

R-759

Application No. 19070 Permit No. 14665

IN NAME OF

GIUSEPPE PONTA

Surveyed August 7 19 53, by H. L. Coffman

DEK 16-71