


T.41S.R.12W.WM

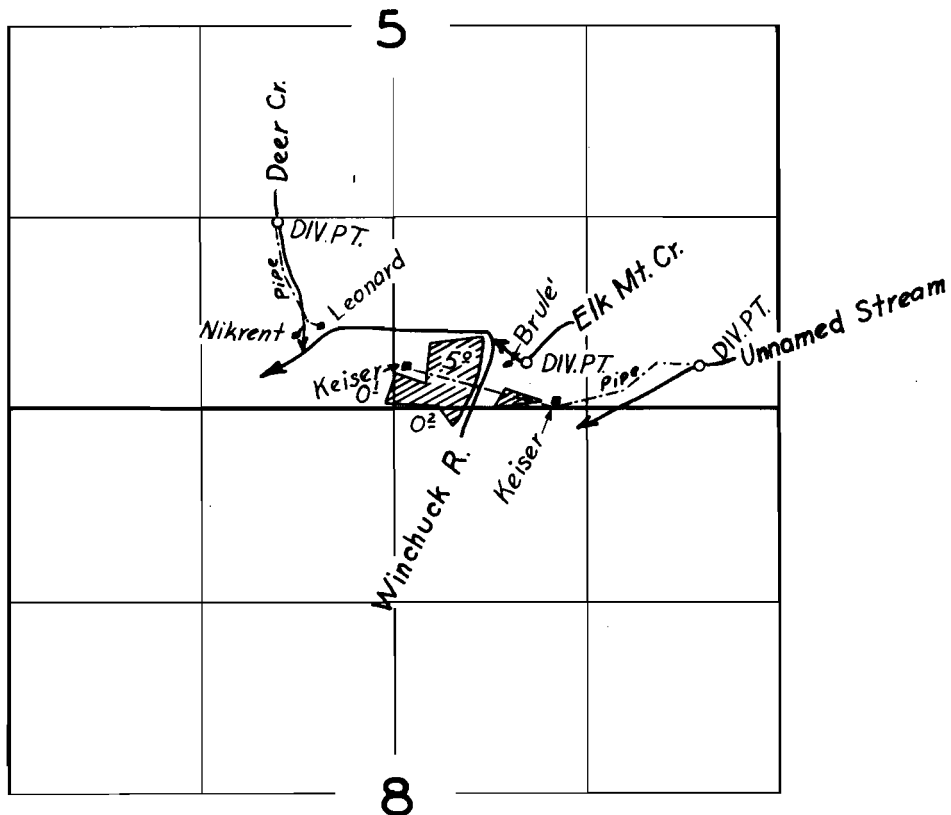

FINAL PROOF SURVEY

UNDER

Application No. 22186 23383 22357 Permit No. 17471 18459 17626

IN NAME OF

K.M. Nikrent & Max J. Leonard
 Mrs. M. H. Brule, Ralph A. Keiser

Surveyed Sept. 21, 1953, by T. Jones