


T.4N. R.10W.W.M.

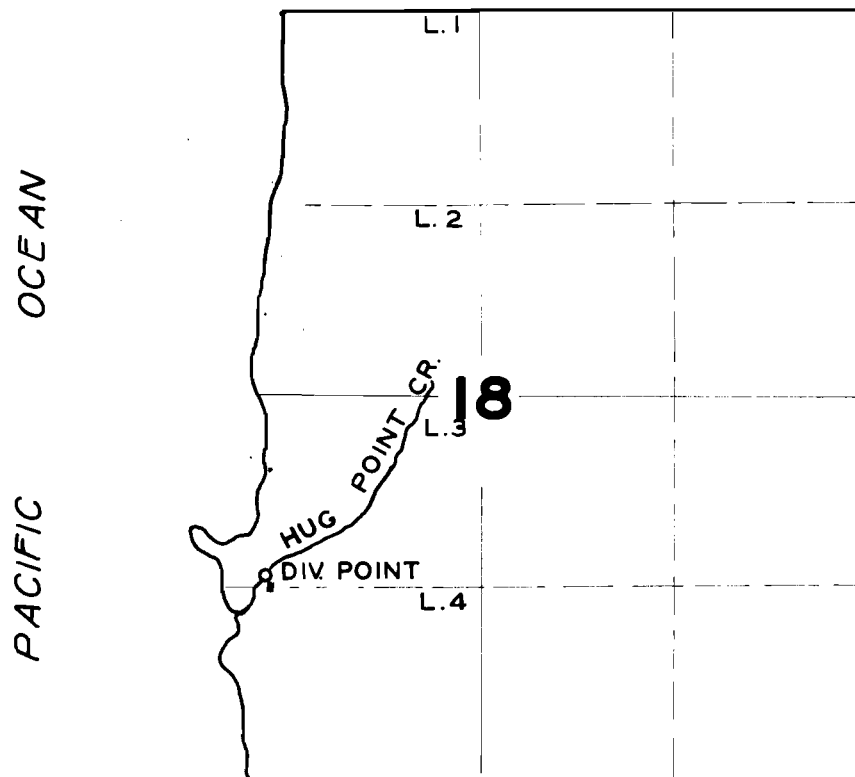

FINAL PROOF SURVEY
UNDER

Application No. 21735 Permit No. 17054
IN NAME OF

G. E. TASKER

Surveyed JULY 19 1950, by H.L. COFFMAN