


T. 4 S. R. 40 E. WM

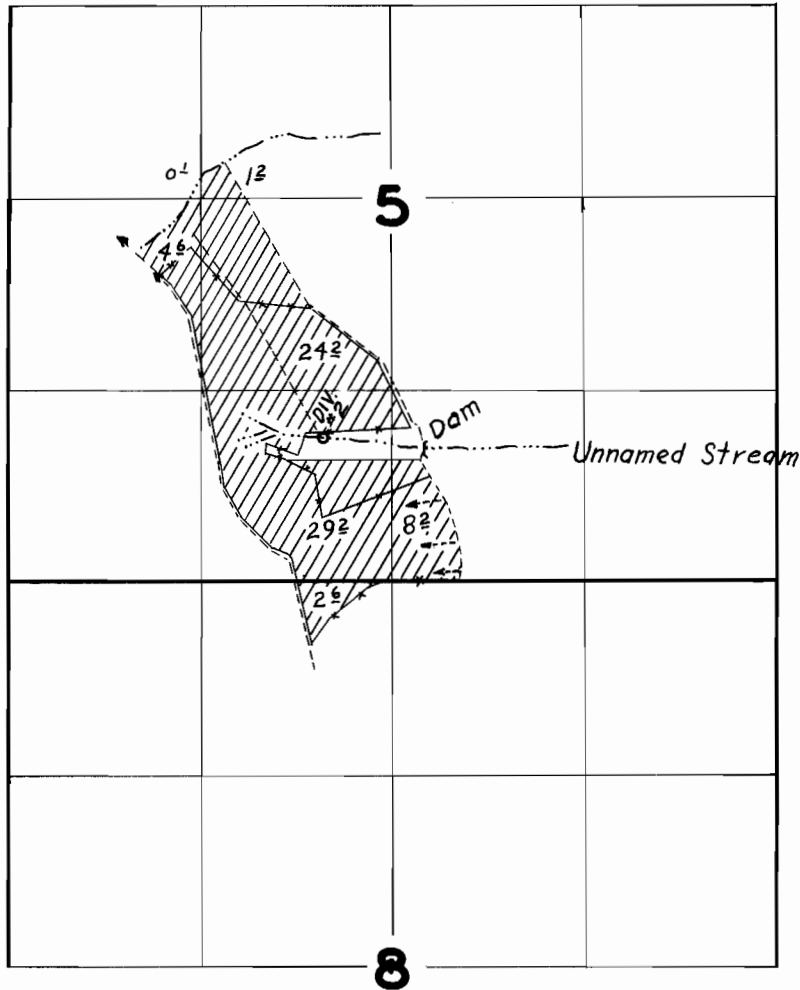

FINAL PROOF SURVEY UNDER

Application No. 23150 Permit No. 18240
IN NAME OF

KeKritz & DeWuhs

Surveyed Oct 10, 1953, by H.L. Coffman