


# T10S.R.6W.W.M.

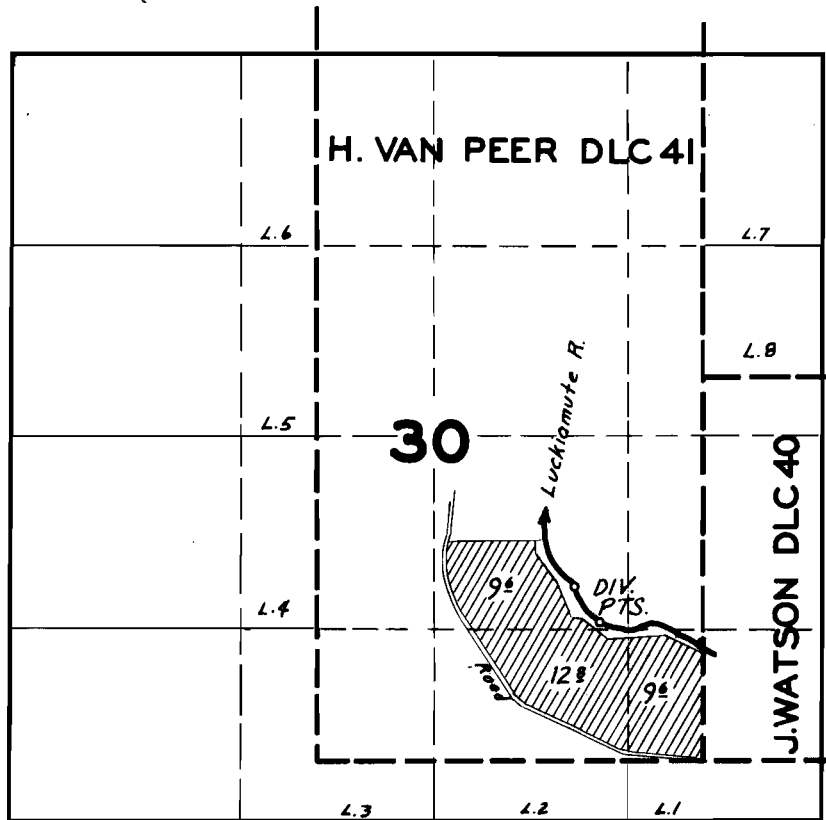

## FINAL PROOF SURVEY

UNDER

Application No. 23233. Permit No. 18347.

IN NAME OF

R. SCHMELZ

Surveyed SEPT 8 1953, by T. JONES