


# T.I.S. R.I.W.WM

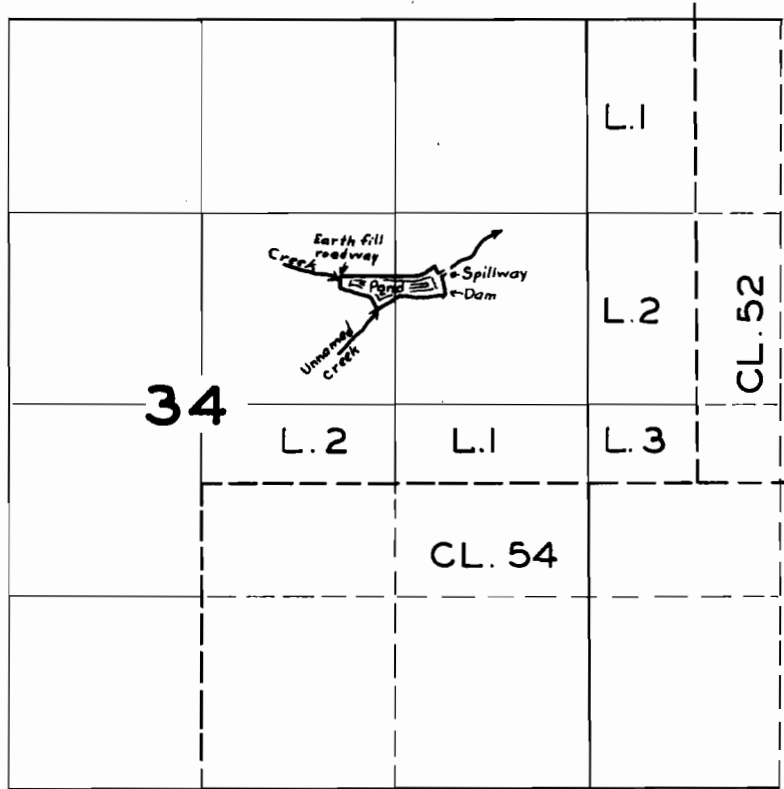

## FINAL PROOF SURVEY

UNDER

Application No. 23882 Permit No. 18829

IN NAME OF

R. E. ELLSON

Surveyed Apr. 15 1953, by H. L. Coffman