


T. 12 S., R. 6 W., W.M.

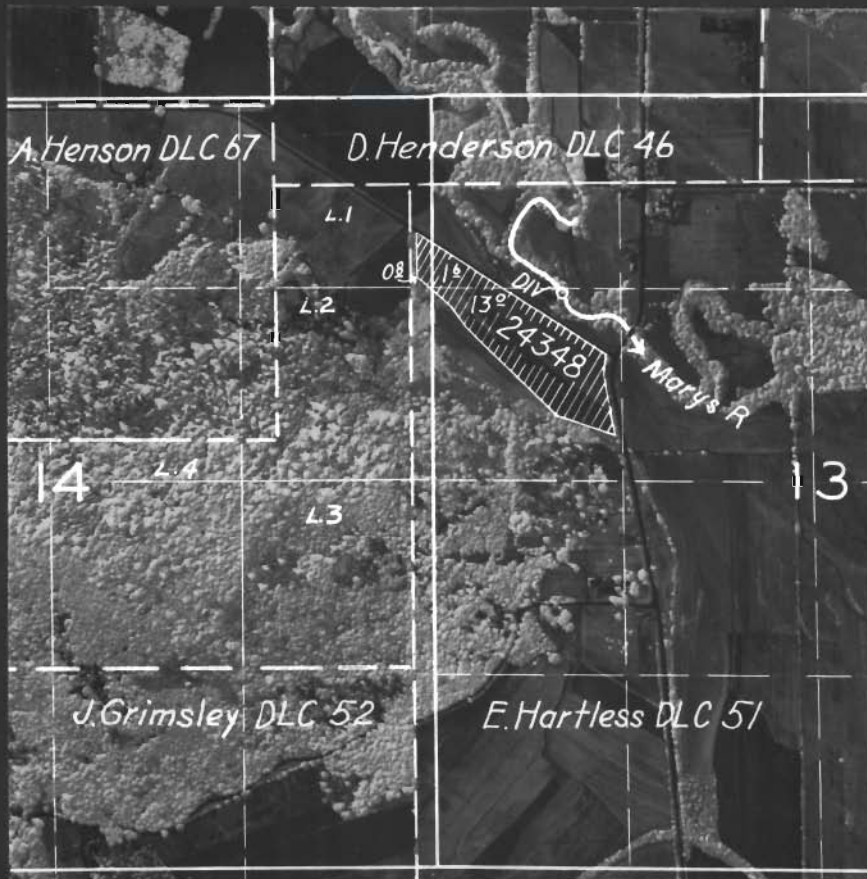

FINAL PROOF SURVEY
UNDER

Application No. 21318 Permit No. 19228
IN NAME OF

Clarence B. Harnden

Surveyed Aug 3 1933, by H. L. Coffman