


T. 13S. R. 5W. W.M.

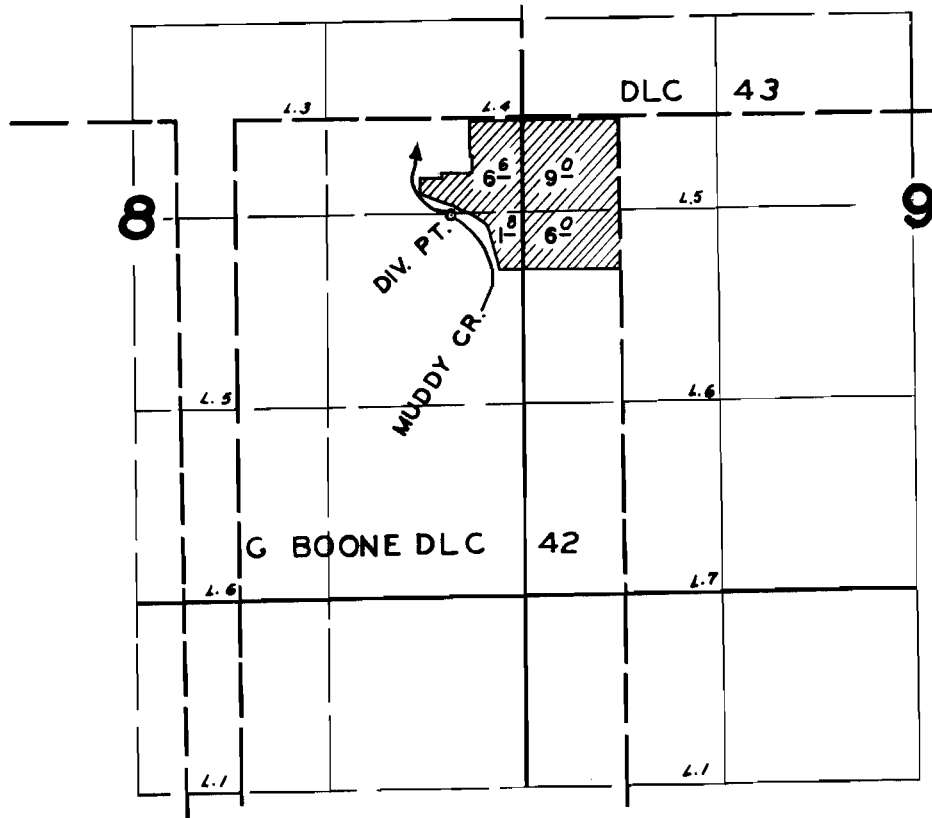

FINAL PROOF SURVEY
UNDER

Application No. 24738 Permit No. 19505
IN NAME OF

HERBERT WRAY &/OR ETHEL JUNE LESTER

Surveyed SEPT. 8, 1953, by H. L. COFFMAN

T. 13 S., R. 5 W., W.M.



FINAL PROOF SURVEY
UNDER

Application No. 24738 Permit No. 19505
IN NAME OF

Herbert Wray and/or Ethel June Lester

Surveyed Sept. 8, 1953, by H. L. Coffman

DFJ-14D-126