


T.3N.R.4W.W.M.

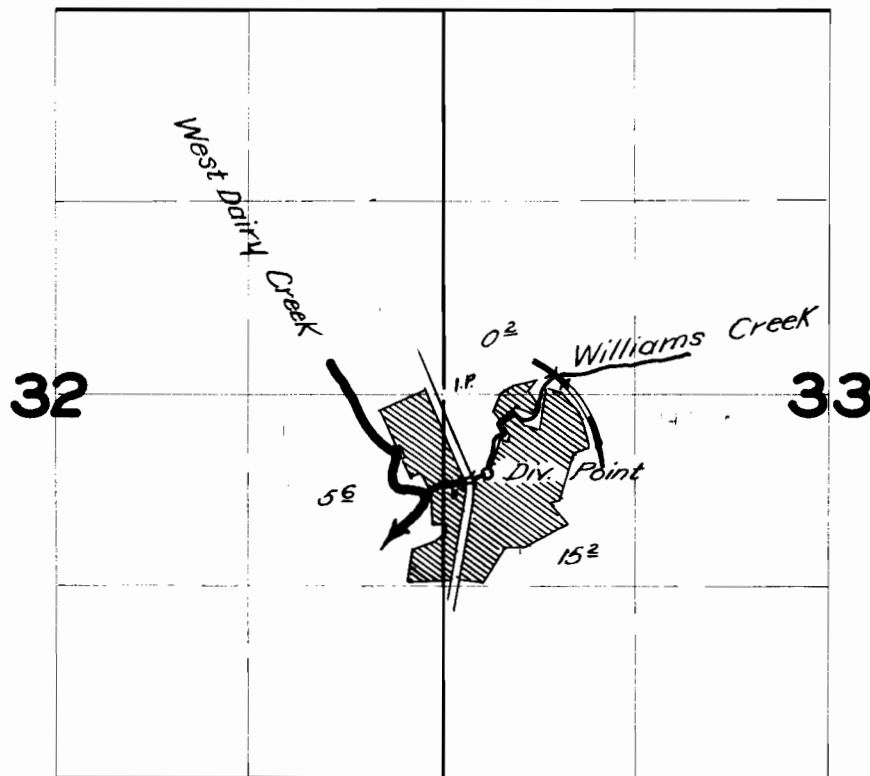

FINAL PROOF SURVEY
UNDER

Application No. 24880... Permit No. 19575...
IN NAME OF

..... PHILLIP S. BURKE

Surveyed 7 / 7 1952, by H. L. COFFMAN