


T. 39 S., R. 8 W. W.M.

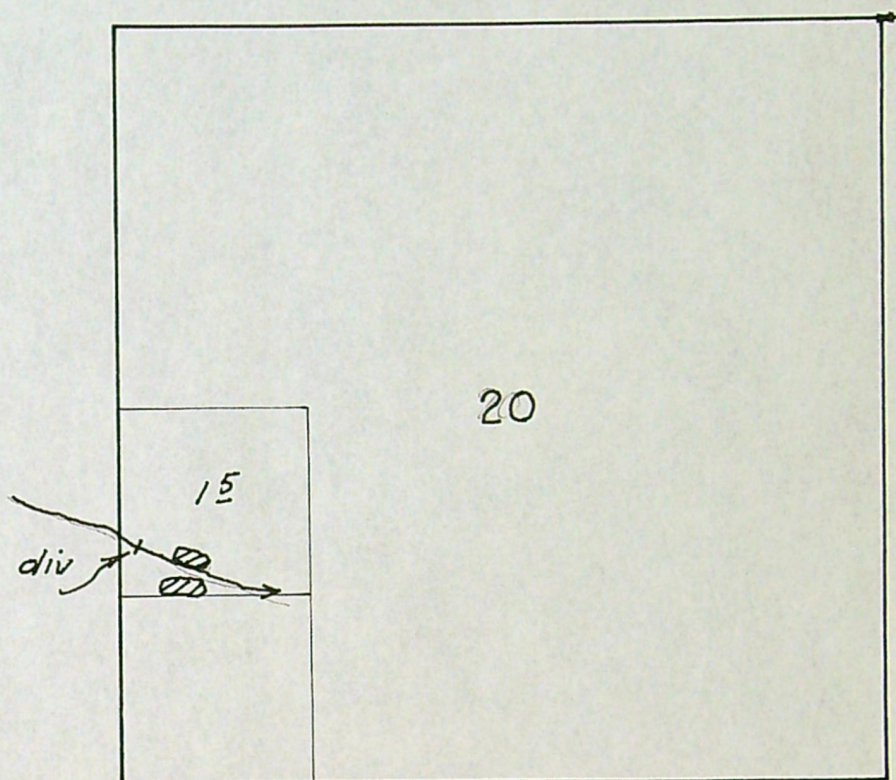

sketched from proof map

App. 25747