


T.34S.R.8W.,W.M.  
Scale 4"=1 Mile Jan. 1953  
Norman L. Lewis.

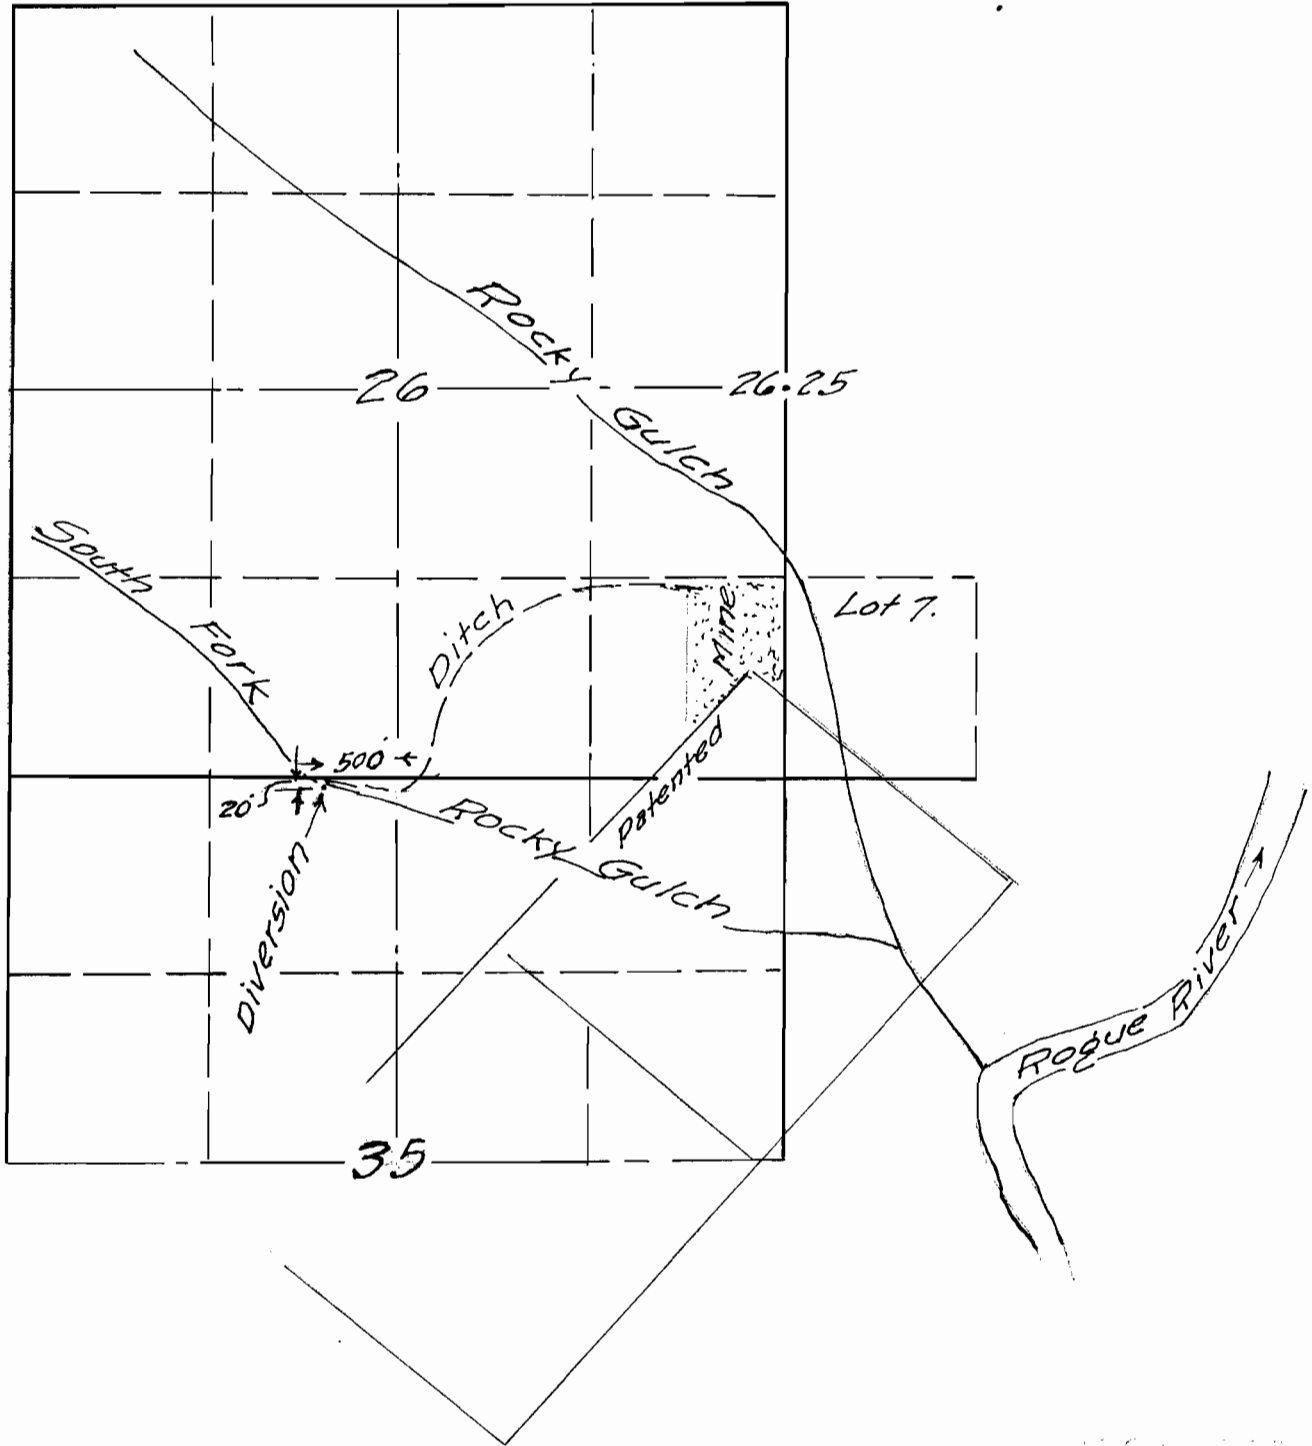

Application No. 28060  
Permit No.

22071