


T.2S.R.2W.W.M.

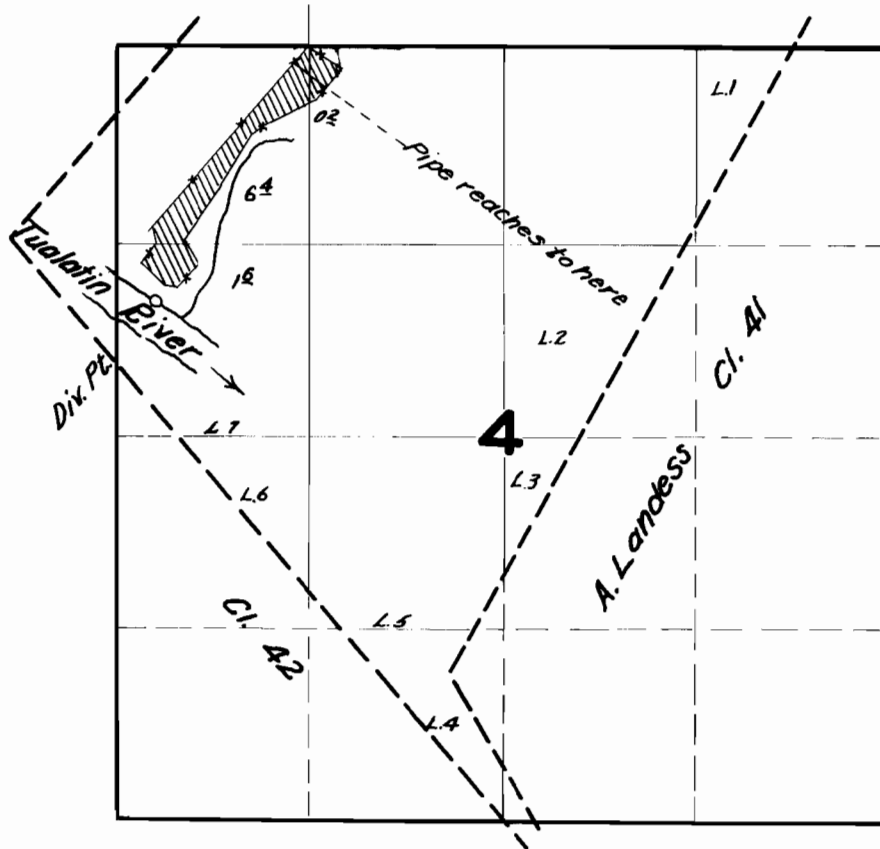

FINAL PROOF SURVEY

UNDER

Application No. 22486 Permit No. 17726

IN NAME OF

FRED J. BERNAU

Surveyed April 2 1953, by H. I. Coffman