


**T.6N.R.35E.W.M.**

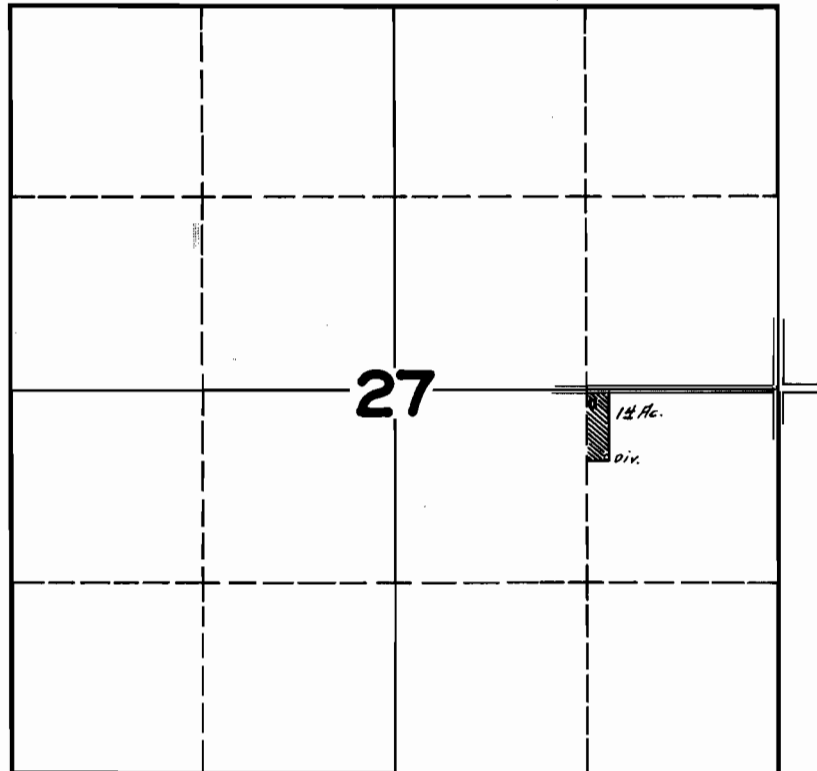

**FINAL PROOF SURVEY**  
UNDER

Application No. 18631 Permit No. 14266

IN NAME OF

W.G. FERGUSON

Surveyed APR. 20 1946, by JAS. E. BUNNELL