




, Range 25 E.W.M. .

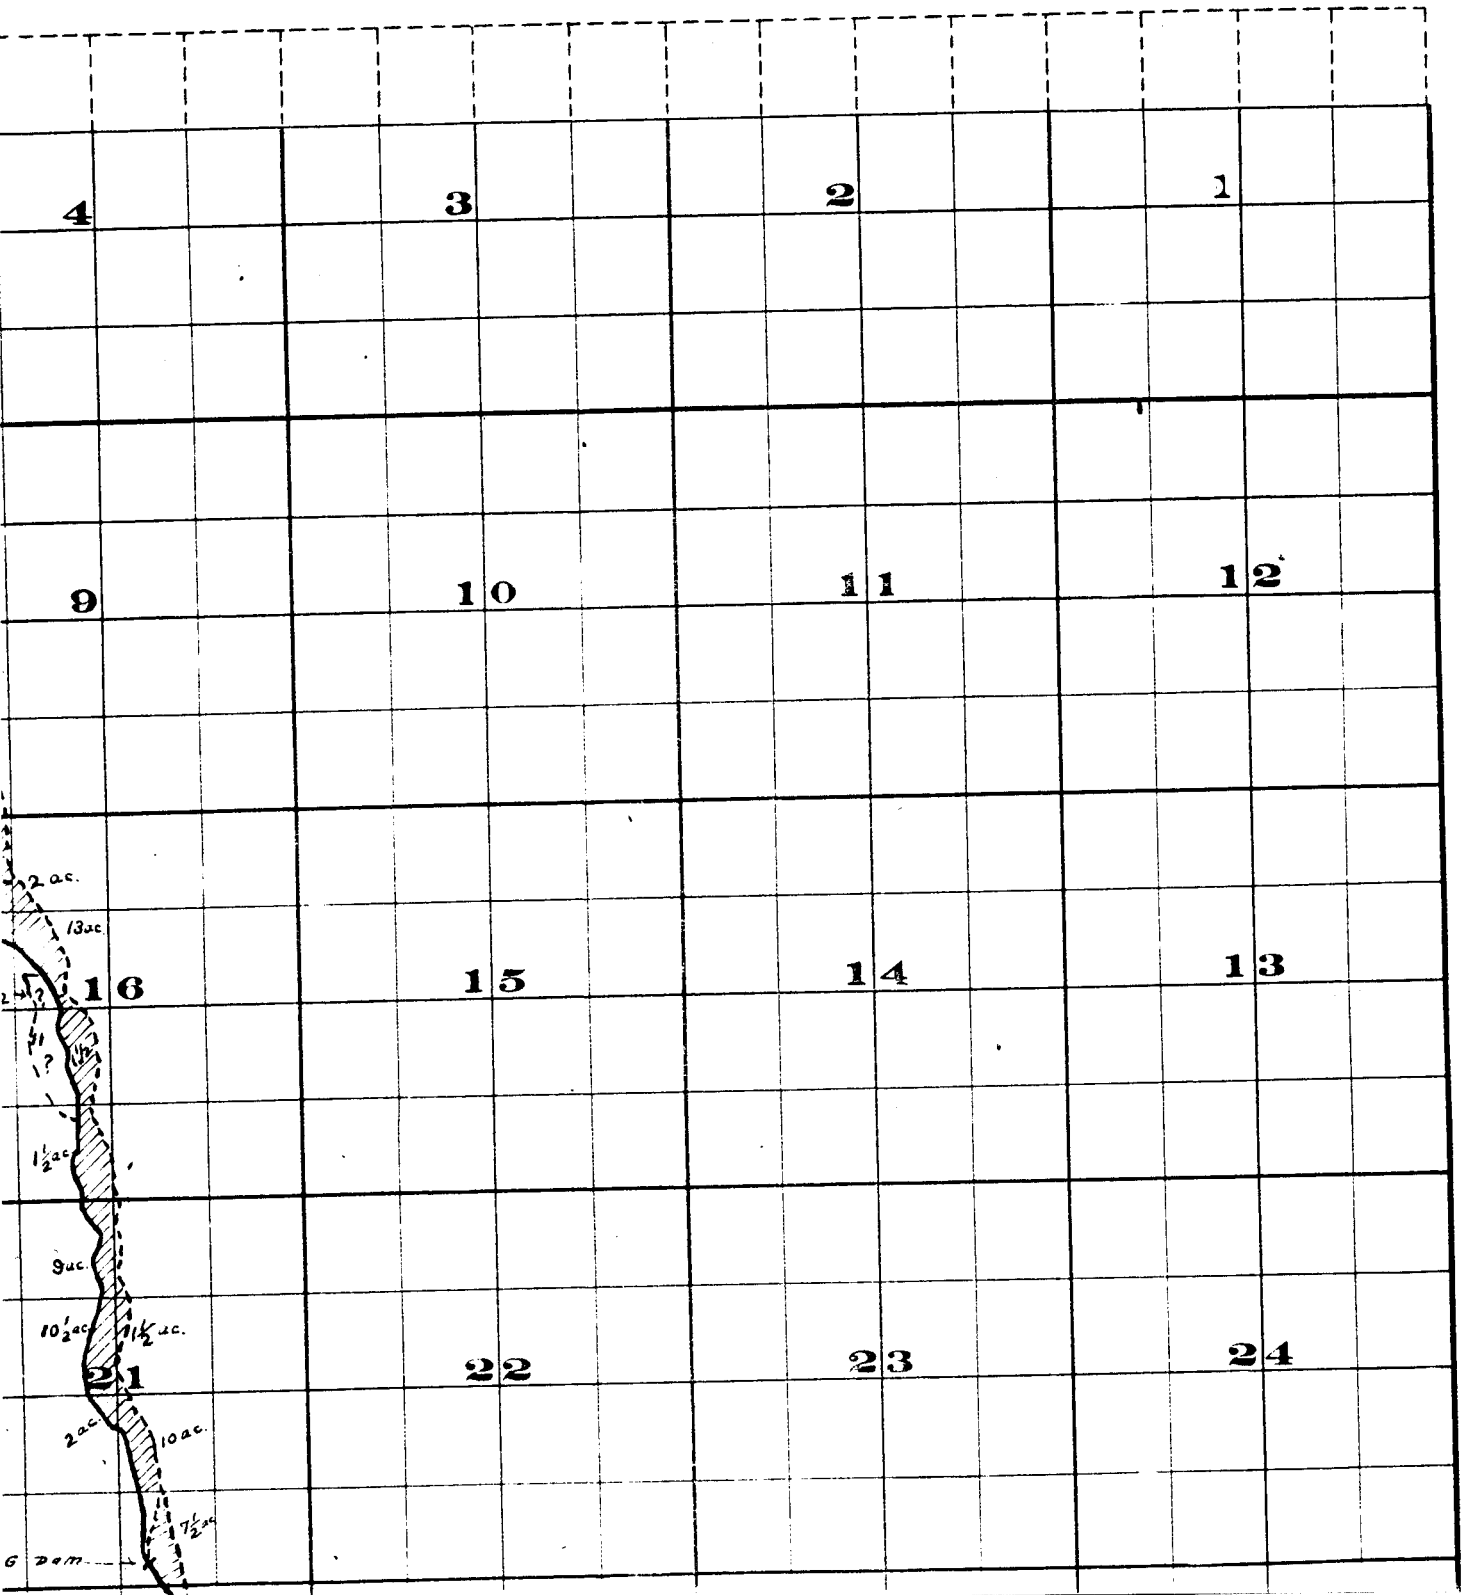

Township 3 S.

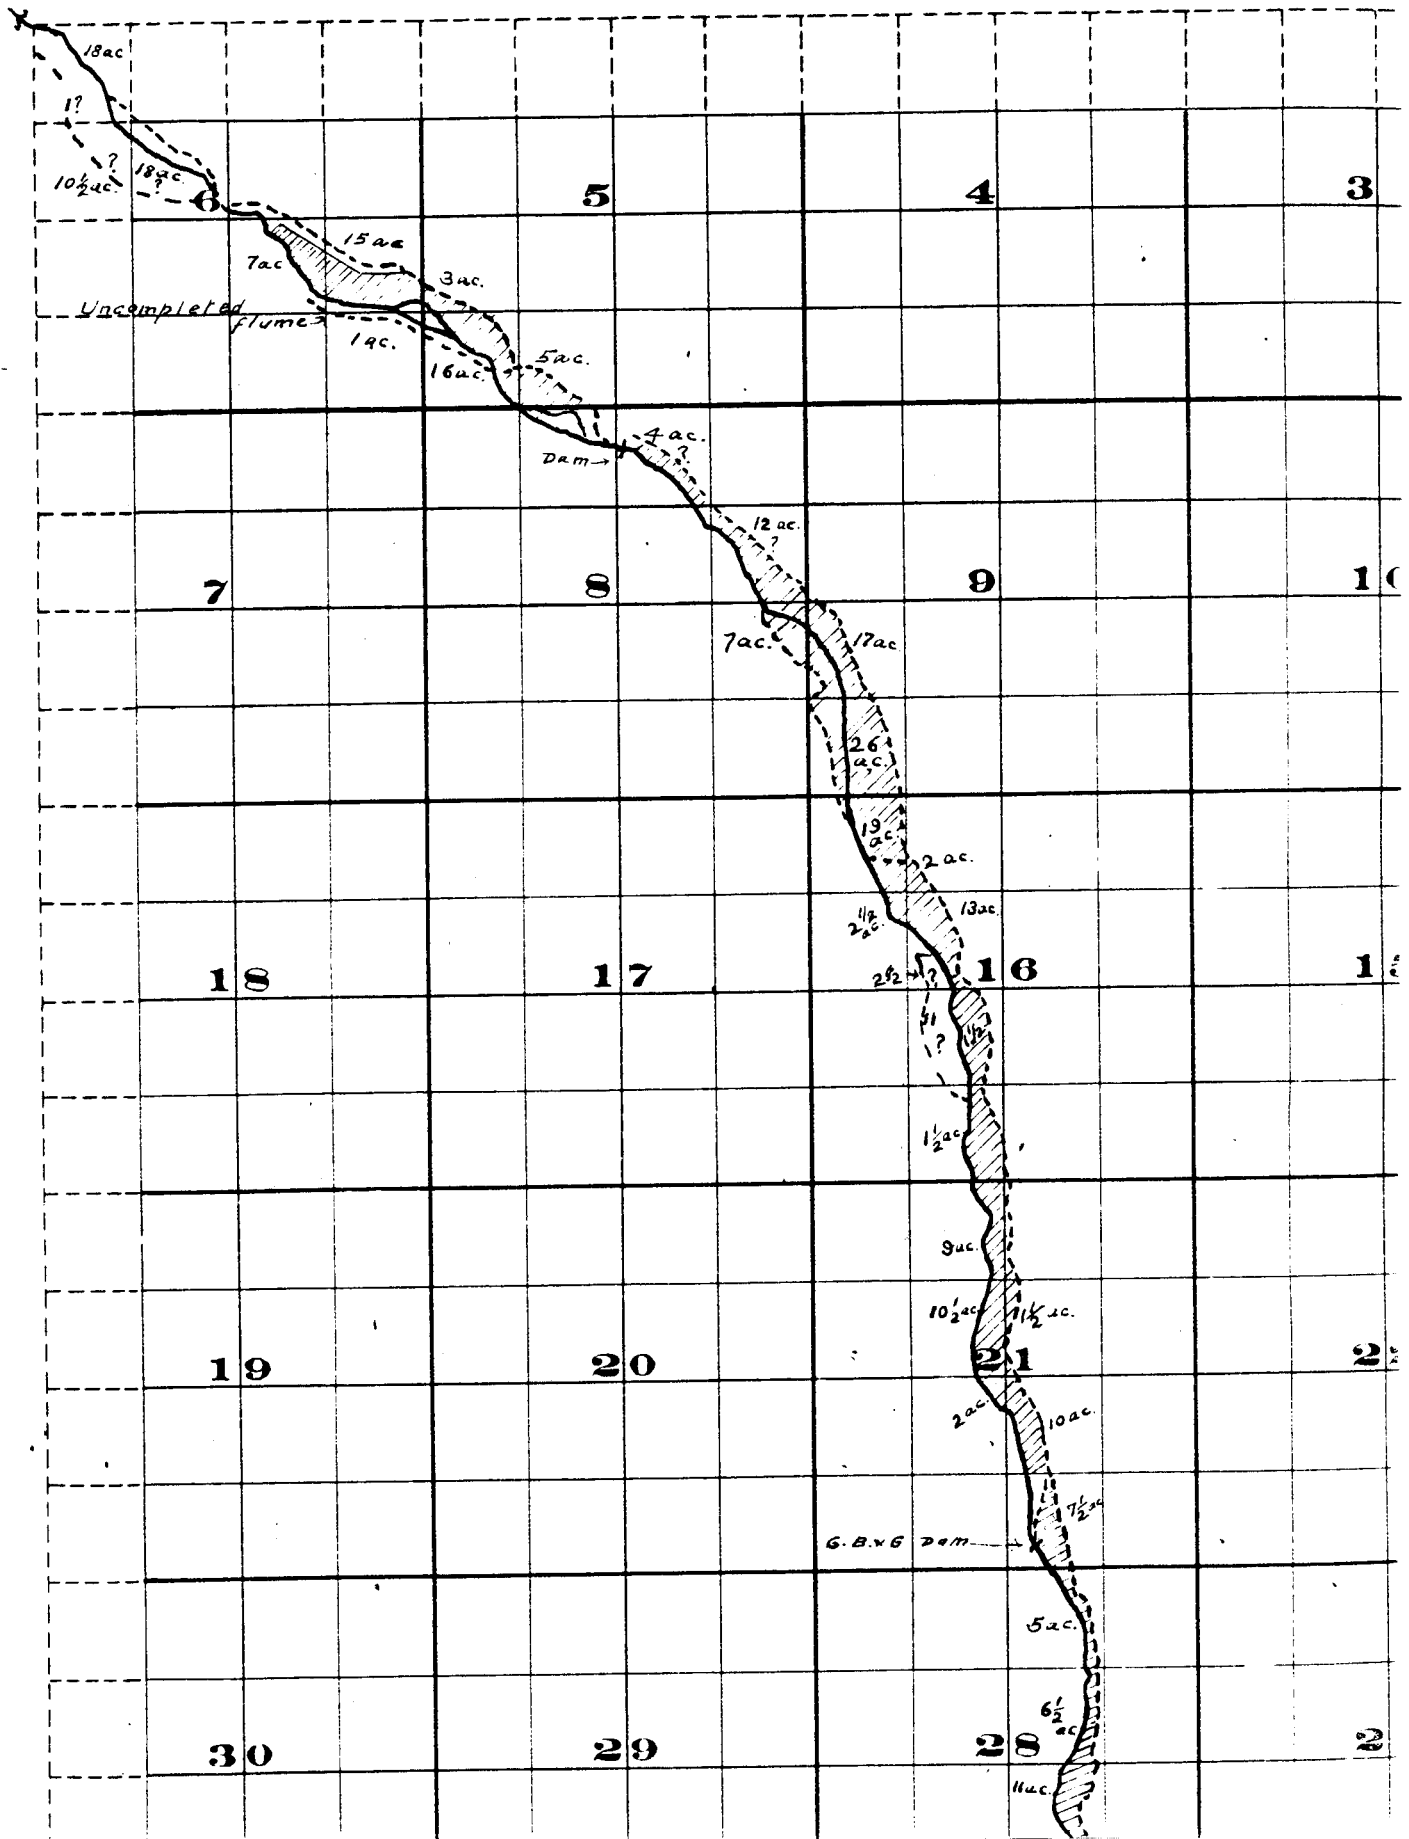

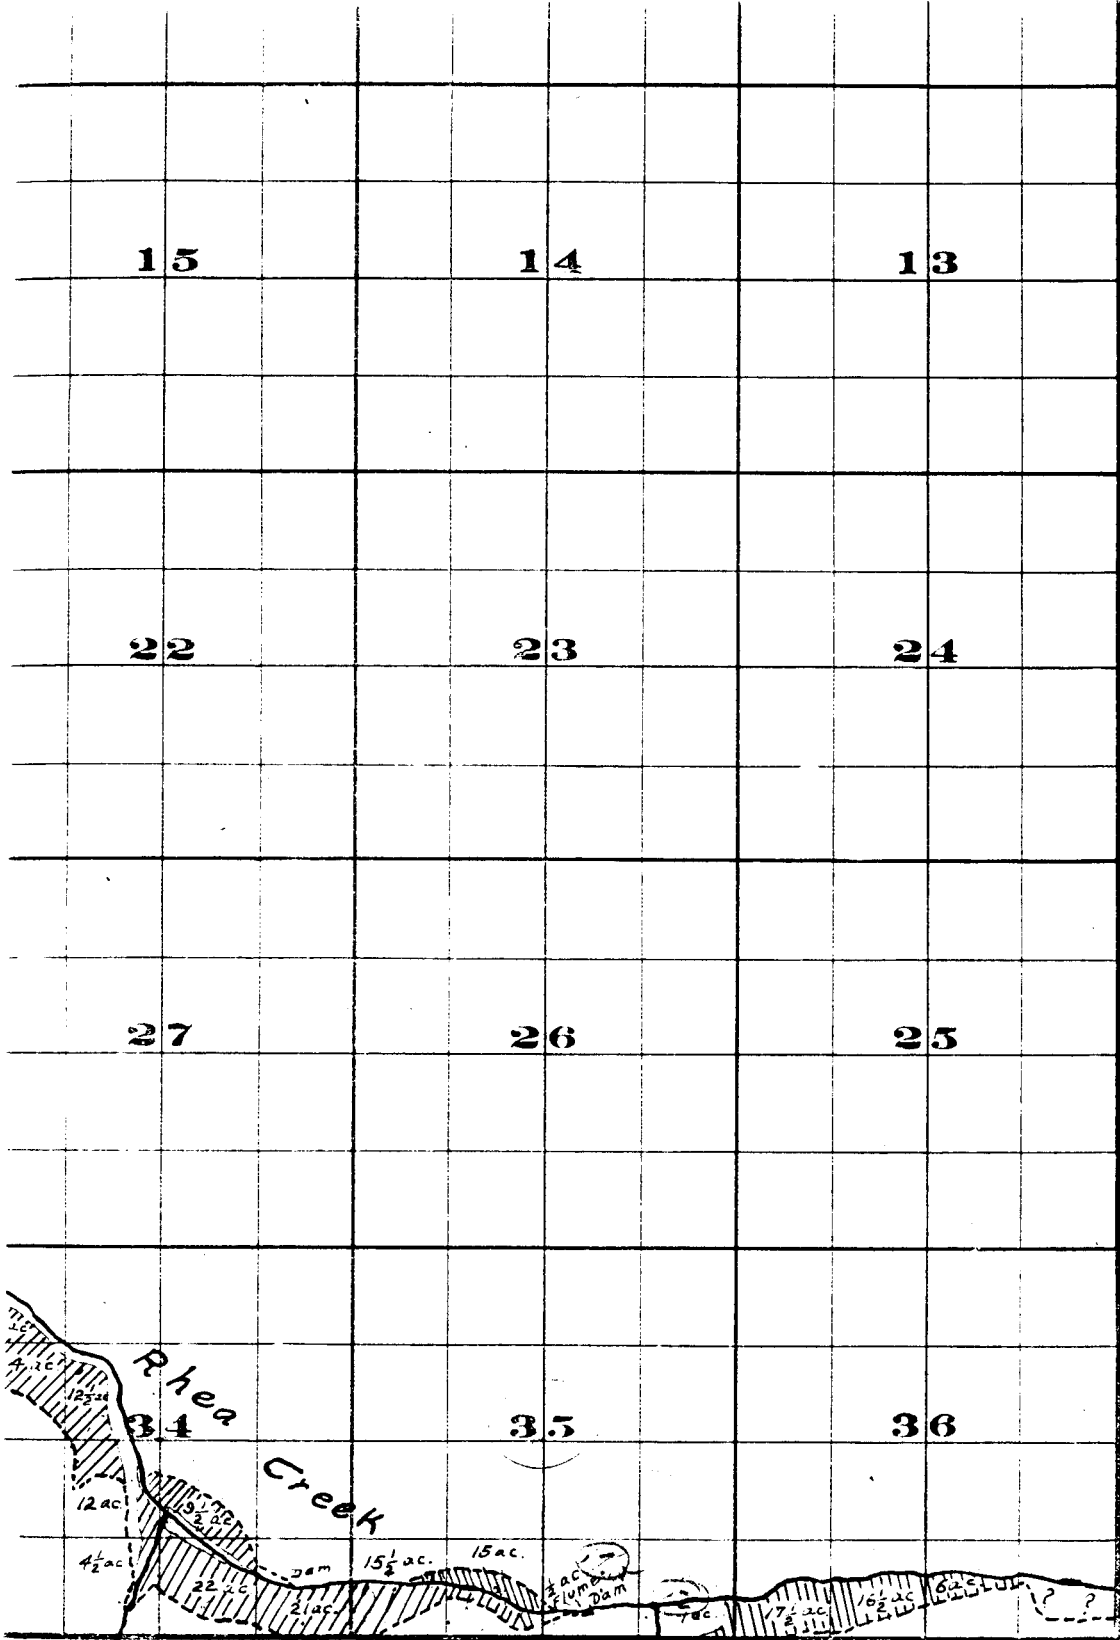

FROM OFFICE OF THE STATE ENGINEER, SALEM, OREGON

July 1909

July 1909

Willow Creek Adjudication

3 S. 25 E.
Part 4 S. 25 E.