


T.38S.R.11 1/2 & 11E.WM

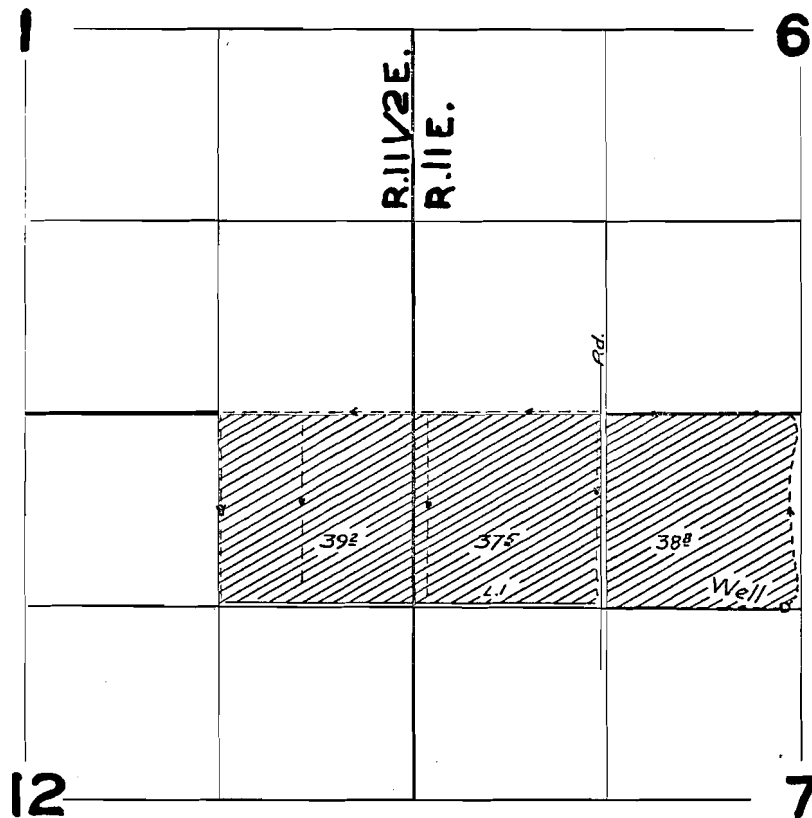

Buck Creek / Yuma Valley wells

FINAL PROOF SURVEY UNDER

Application No. U-222 Permit No. U-265
IN NAME OF

Mrs. Christine W. Mallory

Surveyed Aug. 14, 1953, by J. L. Jones